

WALTHALL  
 D64  
 9-4-79

MISSISSIPPI  
 BOARD OF WATER COMMISSIONERS  
 416 North State Street  
 Jackson, Mississippi 39201

CODED

WATER WELL DRILLERS LOG

9-4-79 date well completed  
 Griner Drilling firm name  
 Walthall county well located

LANDOWNER:  
 Exxon Oil Co. U.S.A.  
 P.O. Box 53226  
 New Orleans, La  
 (mailing address)

description of formations encountered	from	to
Sand	0	42
chalk + sand	42	168
sand + gravel	168	294
sand + chalk	294	336
sand	336	399

WELL LOCATION: 2000' N + 2900' E  
 sec. 13 T. 3 N R. 11 E of SW/4 of  
 2 miles S of Darburn  
 (distance) (direction) (nearest town)

WELL PURPOSE: oil field supply  
 (home, irrigation, municipal, industrial)

CODED

WELL COMPLETION DATA:

- (1) diameter (inches) 3"
- (2) total depth (feet) 400'
- (3) static water level (feet) 70' below top of ground.
- (4) casing steel, 400' (material) (depth)  
 3" (size) if telescope see back.
- (5) screen 42', 358' (length) (depth to top)  
 3" perforated (size) (material)
- (6) pump AC (HP) 75 (yield gpm)  
 (type power)
- (7) electric log (yes or no)
- (organization running log)

(8) how well bottom plugged orange peel

DRILLERS REMARKS:


DEPT. OF NATURAL RESOURCES  
 BUREAU OF LAND & WATER RESOURCES

OCT 26 1979

RECEIVED

If well telescopes please sketch and show depths.

GROUND LEVEL

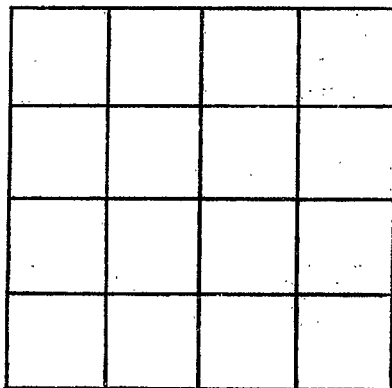

SECTION \_\_\_\_\_

Please indicate well location X.

ADDITIONAL INFORMATION

If more than one screen,  
show locations of each on sketch.