

WALTHALL
 D-71
 10-7-79

MISSISSIPPI
 BOARD OF WATER COMMISSIONERS
 416 North State Street
 Jackson, Mississippi 39201

CODED

WATER WELL DRILLERS LOG

Oct 2 1979 *Reems Miller* *Walthall*
 date well completed firm name county well located

LANDOWNER:	description of formations encountered	from	to
<i>James Tynes</i>			
<i>At 3 James</i> (mailing address)	<i>Red clay</i>	<i>0</i>	<i>17</i>
	<i>Red sand</i>	<i>17</i>	<i>60</i>
	<i>gravel Chalk</i>	<i>60</i>	<i>90</i>
	<i>sand</i>		
	<i>sand + gravel</i>	<i>90</i>	<i>109</i>
WELL LOCATION: sec <i>22</i> T <i>3</i> N R <i>11</i> E <i>7</i> miles <i>north</i> of <i>Yuletown</i> (distance) (direction) (nearest town)			
WELL PURPOSE: <i>home</i> (home, irrigation, municipal, industrial)			
WELL COMPLETION DATA:			
(1) diameter (inches) <i>4"</i>			
(2) total depth (feet) <i>109'</i>			
(3) static water level (feet) <i>80'</i> below top of ground			
(4) casing <i>plastic, cotton</i> (material) (depth)			
(5) screen <i>5'</i> <i>cotton</i> (length) (depth to top)			
<i>4"</i> <i>plastic</i> (size) (material)			
(6) pump <i>1/2</i> <i>10</i> (HP) (yield gpm)			
<i>slut</i> (type power)			
(7) electric log <i>no</i> (yes or no)			
(8) how well bottom plugged <i>wooden plug</i>			
DRILLERS REMARKS:			

CODED


DEPT. OF NATURAL RESOURCES
 BUREAU OF LAND & WATER RESOURCES

SEP 2 - 1980

RECEIVED

If well telescopes please sketch and show depths.

GROUND LEVEL

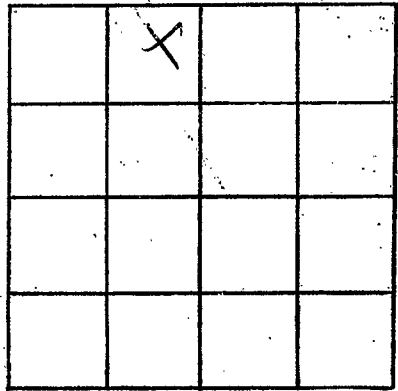

SECTION 22

Please indicate well location X.

ADDITIONAL INFORMATION

If more than one screen, show locations of each on sketch.