

MISSISSIPPI DEPARTMENT OF NATURAL RESOURCES

Bureau of Land and Water Resources

Southport Mall

P.O. Box 10631

Jackson, Mississippi 39209

CODED

WATER WELL DRILLERS LOG

Griner Drilling Service, Inc.

Walthall

WALTHALL
D 72
2-24-81

date well completed

firm name

county well located

LANDOWNER:
Pruet Production
1515 Capital Towers
Jackson, Ms. 39205
(mailing address)

description of formations encountered

from to

sand
pea gravel

0 168

WELL LOCATION: 1500'S + 1500'E

Sec. 3 T. 30 N. R. 11 E of
3-6 Magee Creek NW 1/4
North Dawson (nearest town)

CODED

WELL PURPOSE: oil field
field, irrigation, municipal (municipal)

WELL COMPLETION DATA:

- (1) diameter (inches) 4"
- (2) total depth (feet) 168'
- (3) static water level (feet) 0 below above top of ground.
- (4) casing steel, 147'
(material) (depth)
4"
(size) if telescope see back.
- (5) screen 42', 105'
(length) (depth to top)
4", perforated
(size) (material)
- (6) pump 100
(HP) (yield gpm)
AC
(type power)
- (7) electric log _____
(yes or no)

(organization running log)

(8) how well bottom plugged Orange
Deel

DRILLERS REMARKS:


DEPT. OF NATURAL RESOURCES
BUREAU OF LAND & WATER RESOURCES

MAR 31 1981

RECEIVED

If well telescopes please sketch and show depths.

GROUND LEVEL

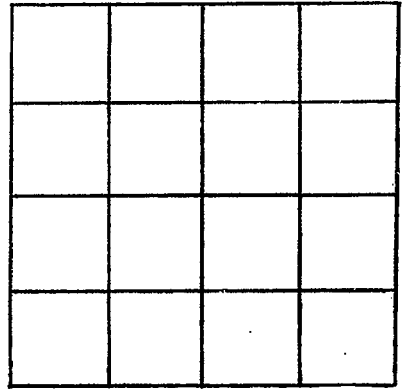

SECTION _____

Please indicate well location X.

ADDITIONAL INFORMATION

If more than one screen, show locations of each on sketch.