

Walsh
D 73
5-13-81

MISSISSIPPI
BOARD OF WATER COMMISSIONERS
416 North State Street
Jackson, Mississippi 39201

WATER WELL DRILLERS LOG


5-13 1981
date well completed

J. L. General Well Serv
firm name

Walsh
county well located


LANDOWNER:	description of formations encountered	CODED	from	to
<i>Dominic Breaux</i>	<i>Red clay</i>		<i>0</i>	<i>20</i>
<i>R.R. Lybster</i> (mailing address)	<i>Red sand</i>		<i>20</i>	<i>110</i>
	<i>limestone sand & gravel</i>		<i>110</i>	<i>127</i>
WELL LOCATION:				
sec. <i>30</i> T. <i>3</i> N R. <i>11</i> E S W				
<i>6</i> miles <i>W</i> of <i>Lybster</i> (distance) (direction) (nearest town)				
WELL PURPOSE: (home, irrigation, municipal, industrial)				
WELL COMPLETION DATA:				
(1) diameter (inches) <i>4</i>				
(2) total depth (feet) <i>127</i>				
(3) static water level (feet) <i>60</i> below top of ground.				
(4) casing <i>PVC</i> , <i>1 1/2</i> (material) (depth)				
<i>4</i> (size) If telescope see back.				
(5) screen <i>16</i> , <i>1 1/2</i> (length) (depth to top)				
<i>4</i> , <i>PVC</i> (size) (material)				
(6) pump <i>5</i> , <i>95</i> (HP) (yield gpm)				
<i>Electric</i> (type power)				
(7) electric log <i>no</i> (yes or no)				
(organization running log)				
(8) how well bottom plugged <i>Sealed</i>				
DRILLERS REMARKS:				

CODED

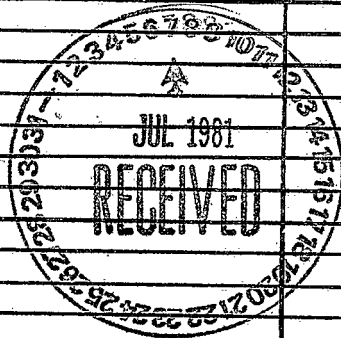

If well telescopes please sketch and show depths.

GROUND LEVEL

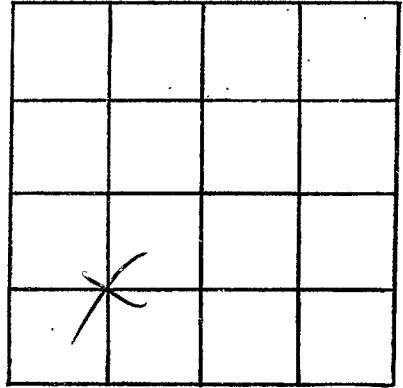

SECTION 30

Please indicate well location X.

ADDITIONAL INFORMATION

If more than one screen,
show locations of each on sketch.