

MISSISSIPPI DEPARTMENT OF NATURAL RESOURCES

Bureau of Land and Water Resources

Southport Mall

P.O. Box 10631

Jackson, Mississippi 39209

WATER WELL DRILLERS LOG

CODED

WALTHALL
D 74
1-31-82

Griner Drilling Service, Inc.

Walthall

1-31-82 date well completed

Griner Drilling Service, Inc. firm name

Walthall county well located

LANDOWNER:

R. E. Williams
P.O. Box 698
Natchez, MS. 39120
(mailing address)

description of formations encountered

from

to

sand, gravel

0 273

chalk

273 399

sand

399 462

WELL LOCATION:

1980' S 4 1930' W

sec. 30 T 30 N R. 11 E of
No. 1 Fernwood Tyler town
(distance) miles (direction) of (nearest town)

WELL PURPOSE:

(home, irrigation, municipal, industrial)

WELL COMPLETION DATA:

- (1) diameter (inches) 3"
- (2) total depth (feet) 462'
- (3) static water level (feet) 30' ^{below} / _{above} top of ground.
- (4) casing Steel, 462' (material) (depth)
3" (size) if telescope see back.
- (5) screen 42' / 420' (length) (depth to top)
3" perforated (size) (material)
- (6) pump — 70 (HP) (yield gpm)
AC (type power)
- (7) electric log — (yes or no)

CODED

(organization running log)

- (8) how well bottom plugged

peel

orange


DRILLERS REMARKS:

DEPT. OF NATURAL RESOURCES
BUREAU OF LAND & WATER RESOURCES

RECEIVED
FEB 4 1982

If well telescopes please
sketch and show depths.

GROUND LEVEL

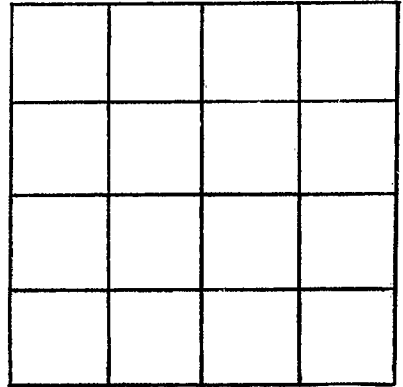

SECTION _____

Please indicate well location X.

ADDITIONAL INFORMATION

If more than one screen,
show locations of each on sketch.