

MISSISSIPPI DEPARTMENT OF NATURAL RESOURCES

Bureau of Land and Water Resources

Southport Mall

P.O. Box 10631

Jackson, Mississippi 39209

WATER WELL DRILLERS LOG

Griner Drilling Service, Inc.

Walthall

9-27-82 date well completed

firm name

county well located

LANDOWNER:
 Pruet Production
 1515 Capital Towers
 Jackson, Ms. 39429
 (mailing address)

description of formations encountered	from	to
clay	0	20
Sand, gravel	20	168
sand, clay	168	210
sand, gravel	210	252
clay	252	302
clay, gravel	302	400

WELL LOCATION: 2000 W 1651 E
 No. sec. 3 T. 30 N R. 11 E SW
 malone Darbune
 3/4 (distance) miles (direction) of (nearest town)

WELL PURPOSE: oil field supply
 (home, irrigation, municipal, industrial)

WELL COMPLETION DATA:

- (1) diameter (inches) 3"
- (2) total depth (feet) 400'
- (3) static water level (feet) 70' below top of ground.
- (4) casing steel 252' (material) (depth)
 3" (size) if telescope see back.
- (5) screen 42' 210' (length) (depth to top)
 3" (size) perforated (material)
- (6) pump AC (HP) 70 (yield gpm)
 (type power)
- (7) electric log (yes or no)
 (organization running log)
- (8) how well bottom plugged orange
 peel

CODED
 270
 252

DEPT. OF NATURAL RESOURCES
 BUREAU OF LAND & WATER RESOURCES


OCT 12 1982

RECEIVED

DRILLERS REMARKS:

If well telescopes please
sketch and show depths.

GROUND LEVEL

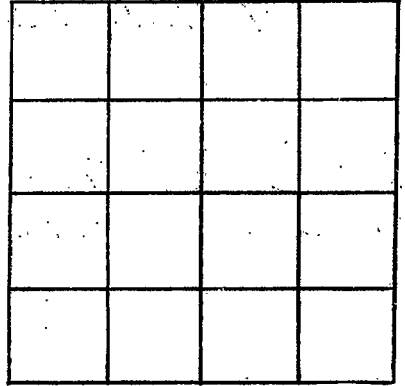

SECTION _____

Please indicate well location X.

ADDITIONAL INFORMATION

If more than one screen,
show locations of each on sketch.