

MISSISSIPPI DEPARTMENT OF NATURAL RESOURCES

Bureau of Land and Water Resources

Southport Mall

P.O. Box 10631

Jackson, Mississippi 39209

WATER WELL DRILLERS LOG

Griner Drilling Service, Inc.

Walthall

Walthall
D 76
5-25-83

date well completed

firm name

county well located

5-25-83

LANDOWNER:
B.G. Fortenberry Co.
P.O. Box 88
Natchez, Ms. 39120
(mailing address)

description of formations encountered	from	to
<i>SAND - gravel</i>	<i>0</i>	<i>252</i>

WELL LOCATION: *10415 + 1650 E*
No. 333 T 30 N R 11 E of
Packwood *W Natchez*
Wells *North Carbon Field*
miles (distance) (direction) (nearest town)

WELL PURPOSE: *oilfield supply*
(home, irrigation, municipal, industrial)

WELL COMPLETION DATA:

- (1) diameter (inches) *3"*
- (2) total depth (feet) *252'*
- (3) static water level (feet) *10'* below top of ground. above
- (4) casing *Steel*, *252'*
(material) (depth)
3"
(size) If telescope see back.
- (5) screen *42'*, *210'*
(length) (depth to top)
3", *perforated*
(size) (material)
- (6) pump *100*
(HP) (yield gpm)
AC
(type power)
- (7) electric log
(yes or no)

(organization running log)

(8) how well bottom plugged *Orange Peel*

DRILLERS REMARKS:

CODED


DEPT. OF NATURAL RESOURCES
BUREAU OF LAND & WATER RESOURCES

JUN - 3 1983

RECEIVED

If well telescopes please
sketch and show depths.

GROUND LEVEL

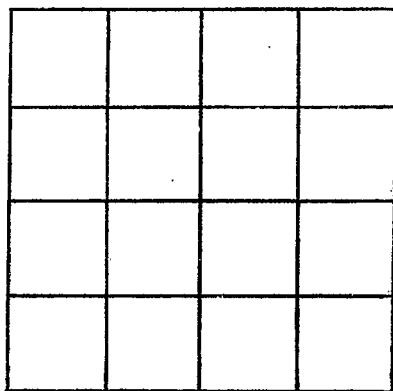

SECTION _____

Please indicate well location X.

ADDITIONAL INFORMATION

If more than one screen,
show locations of each on sketch.