

MISSISSIPPI DEPARTMENT OF NATURAL RESOURCES

Bureau of Land and Water Resources

Southport Mall

P.O. Box 10631

Jackson, Mississippi 39209

WATER WELL DRILLERS LOG

D78
 Walthall Co
 3-6-84

CODED

3-6-84 Griner Drilling Service, Inc.

Walthall

date well completed

firm name

county well located

LANDOWNER:	description of formations encountered	from	to
See Land Drilling 900 Dunn Street Houma, La. 70360 (mailing address)	clay	0	10
WELL LOCATION: 2360' N of 988' E	sand, gravel	10	180
No. 2 T-3 N R-11 E SW 1/4 Mourner Estate North Dardun Field (distance) miles (direction) of (nearest town)	streaks clay, sand	180	189
WELL PURPOSE: oil field supply (home, irrigation, municipal, industrial)			
WELL COMPLETION DATA:			
(1) diameter (inches) 3"			
(2) total depth (feet) 189'			
(3) static water level (feet) Top below top of ground.			
(4) casing steel 189' (material) (depth)			
3" (size) If telescope see back.			
(5) screen 42' 147' (length) (depth to top)			
3" perforated (size) (material)			
(6) pump 80 (HP) (yield gpm)			
AC (type power)			
(7) electric log (yes or no)			
(organization running log)			
(8) how well bottom plugged orange peel			
DRILLERS REMARKS:			

DEPT. OF NATURAL RESOURCES
 BUREAU OF LAND & WATER RESOURCES

MAR 27 1984


RECEIVED

If well telescopes please sketch and show depths.

GROUND LEVEL

204/3

666

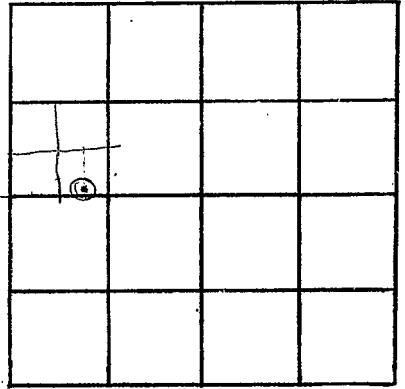

SECTION _____

Please indicate well location X.

ADDITIONAL INFORMATION

If more than one screen, show locations of each on sketch.