

WALTHALL

D 79

## MISSISSIPPI DEPARTMENT OF NATURAL RESOURCES

Bureau of Land and Water Resources

Southport Mall

P.O. Box 10631

Jackson, Mississippi 39209

## WATER WELL DRILLERS LOG

CODED

April 13 1984

1984

Reiner Well Sec

Walthall

date well completed

firm name

county well located

## LANDOWNER:

Ronnie Holmes

At Tybourn  
(mailing address)

## description of formations encountered

from

to

Red Clay

0 19

Red Chalk

19 73

sand rock

75 76

sand &amp; gravel

76 90

clay &amp; sand

90 135

sand &amp; gravel

135 142

## WELL LOCATION:

sec. 19 T. 3 N. R. 12 E.  
5 miles South of Osburn  
(distance) (direction) (nearest town)

## WELL PURPOSE:

(home, irrigation, municipal, industrial)

## WELL COMPLETION DATA:

- (1) diameter (inches) 4"
- (2) total depth (feet) 142
- (3) static water level (feet) 71' below top of ground.

- (4) casing plastic, bottom  
(material) (depth)

(size) if telescope see back.

- (5) screen 6' 136'  
(length) (depth to top)

4" plastic  
(size) (material)

- (6) pump 3 hp 12  
(HP) (yield gpm)

electric  
(type power)

- (7) electric log no  
(yes or no)

(organization running log)

- (8) how well bottom plugged

back wash


DRILLERS REMARKS:

DEPT. OF NATURAL RESOURCES  
BUREAU OF LAND & WATER RESOURCES

JUL - 2 1984  
RECEIVED

If well telescopes please  
sketch and show depths.

GROUND LEVEL

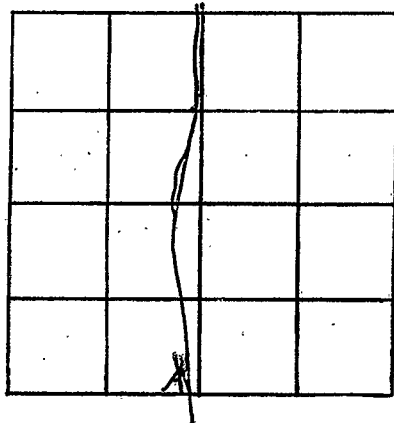

SECTION 19

Please indicate well location X.

ADDITIONAL INFORMATION

If more than one screen,  
show locations of each on sketch.