

MISSISSIPPI DEPARTMENT OF NATURAL RESOURCES

Bureau of Land and Water Resources

Southport Mall

P.O. Box 10631

Jackson, Mississippi 39209

WATER WELL DRILLERS LOG

Griner Drilling Service, INC.

Walthall

Walthall CODED
 D 80
 8-8-88

8-8-88 date well completed

Griner Drilling Service, INC. firm name

Walthall county well located

LANDOWNER:
Exeter Drilling Co
P.O. Box 1478
Houston, TX 77001
 (mailing address)

description of formations encountered	from	to
<i>sand</i>	<i>0</i>	<i>20</i>
<i>sand</i>	<i>20</i>	<i>100</i>


WELL LOCATION: *1500 S 130 W*
 sec. *3* T. *3* N. R. *11* E of *NECOR*
No. 1 N. Darbun Field
 (distance) (direction) (nearest town)

<i>pea gravel</i>	<i>100</i>	<i>168</i>
-------------------	------------	------------

WELL PURPOSE: *oilfield rig*
 (home, irrigation, municipal, industrial)
supply

WELL COMPLETION DATA:

- (1) diameter (inches) *3"*
- (2) total depth (feet) *168'*
- (3) static water level (feet) *3'* below top of ground.
- (4) casing *160' steel*, (material) (depth)
3" (size) If telescope see back.
- (5) screen *42'*, *118'* (length) (depth to top)
3", *perforated* (size) (material)
- (6) pump *—* *100* (HP) (yield gpm)
AC (type power)
- (7) electric log *—* (yes or no)
 (organization running log)
- (8) how well bottom plugged *orange peel*

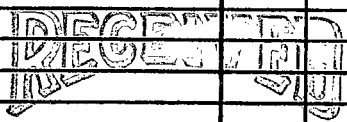


AUG 22 1988

Department of Natural Resources
 Bureau of Land & Water Resources

DRILLERS REMARKS:

If well telescopes please sketch and show depths.

GROUND LEVEL

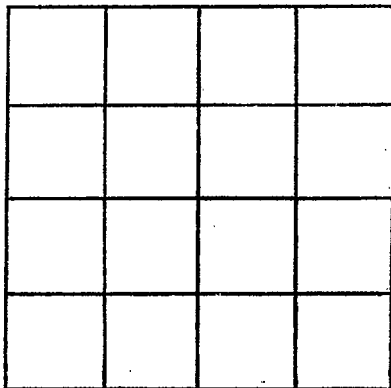

SECTION _____

Please indicate well location X.

ADDITIONAL INFORMATION

If more than one screen, show locations of each on sketch.