

MISSISSIPPI DEPARTMENT OF NATURAL RESOURCES

Bureau of Land and Water Resources

309 D or 32913 Southport Mall  
P.O. Box 10631

CODED

Jackson, Mississippi 39209

WATER WELL DRILLERS LOG

Griner Drilling  
Service, Inc.

Walthall

WALTHALL  
D 81

11-25-89  
date well completed

Griner Drilling  
Service, Inc.  
firm name

Walthall  
county well located

LANDOWNER:	description of formations encountered	from	to
Par-Co. Drilling Co. P.O. Box 873 Natchez, Ms. 39120 (mailing address)			
WELL LOCATION: 330'W + 660'E sec. 3 T. 3 N R. 11 E of N. Darby Field (distance) (direction) (nearest town)			
WELL PURPOSE: oilfield rig (home, irrigation, supply, industrial)			
WELL COMPLETION DATA:			
(1) diameter (inches) 3"			
(2) total depth (feet) 253'			
(3) static water level (feet) 20' below top of ground.			
(4) casing PVC 253' (material) (depth)			
3" if telescope see back. (size)			
(5) screen PVC 30' 223' (length) (depth to top)			
3" PVC screen (size) (material)			
(6) pump 100 (HP) (yield gpm)			
AC (type power)			
(7) electric log (yes or no) 3" PVC plug (organization running log) well plugged bottom			
(8) how well plugged			

RECEIVED


DEC 14 1989

Department of Natural Resources  
Bureau of Land & Water Resources

DRILLERS REMARKS:

If well telescopes please  
sketch and show depths.

GROUND LEVEL

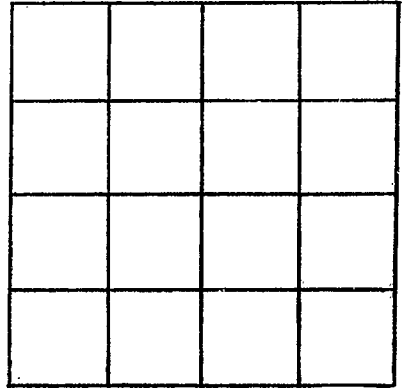

SECTION \_\_\_\_\_

Please indicate well location X.

ADDITIONAL INFORMATION

If more than one screen,  
show locations of each on sketch.