

MISSISSIPPI DEPARTMENT OF ENVIRONMENTAL QUALITY

Office of Land and Water Resources

P. O. Box 10631
Jackson, MS 39289-0631
WATER WELL DRILLERS LOG

COUNTY WELL LOCATED <i>Walton</i>	
WELL NUMBER D-810	CODED
DATE WELL COMPLETED 12-4-03	

PERMIT NUMBER
NAME OF DRILLING FIRM <i>Fitzgerald Well Service</i>

NAME & MAILING ADDRESS OF LANDOWNER <i>Rials Dairy</i> <i>RR Darbus</i>			
Latitude:			
Longitude:			
WELL LOCATION	SEC <i>12</i>	TOWNSHIP <i>3</i>	RANGE <i>11</i>
DISTANCE DIRECTION NEAREST TOWN <i>11</i> Miles <i>NE</i> of <i>Tylertown</i>			
OTHER LANDMARK			
WELL PURPOSE: Home, Irrigation, Municipal, Industrial, Fish Pond, etc. <i>Dairy Barn</i>			

PUMP DATA			
PUMP TYPE (Circle One): <input checked="" type="radio"/> Submersible, Turbine, Jet Flowing Well, Other (Describe) _____			
POWER TYPE (Circle One): <input checked="" type="radio"/> Electric, Tractor, Diesel, Gasoline Butane, Other (Describe) _____ H/P <i>5</i>			

DESCRIPTION OF FORMATIONS ENCOUNTERED	FROM	TO
<i>clay</i>	<i>0</i>	<i>25</i>
<i>sand</i>	<i>25</i>	<i>70</i>
<i>Sand & gravel</i>	<i>70</i>	<i>95</i>
<i>clay</i>	<i>95</i>	<i>120</i>
<i>Fine Sand</i>	<i>120</i>	<i>150</i>
<i>Coarse Sand</i>	<i>150</i>	<i>175</i>

WELL DATA		
Well Depth <i>175'</i>	Casing Diameter (In.) <i>4"</i>	Casing Length (Ft.) <i>155'</i>
Type of Casing <i>PVC</i>	Hole Depth <i>175'</i>	Depth to Static Water Level <i>70'</i>
TYPE OF COMPLETION: (Circle One or More): <input checked="" type="radio"/> Gravel Packed, Underreamed, Telescoped, <input type="radio"/> Natural Development, Open Hole, Other (Describe) _____		
WELL GROUTED TO A DEPTH OF <i>10</i> FEET Type Grout (circle one): Cement, Bentonite, or <input checked="" type="radio"/> Mix		

SCREEN DATA		
Diameter - Inches <i>4"</i>	Length - Feet <i>20'</i>	Slot Size - Inches <i>.012</i>
Screen Type <i>PVC</i>	Depth to Bottom - Feet <i>175'</i>	

RECEIVED	
JAN 15 2004	
BY: OLWR	
Top of Lap Pipe or Reduction in Casing	
FEET	IF TELESCOPED OR MORE THAN ONE SCREEN: USE BACK PAGE

I certify that the well was drilled, constructed and completed in accordance with all applicable Requirements of the Mississippi Department of Environmental Quality and/or the Mississippi Department of Health regulations and state laws.


Beard Fitzgerald *029*
Signature of Licensed Driller and License No.

12-5-03
Date

Additional Information Required On Back

If well telescopes please sketch and show depths.

GROUND LEVEL

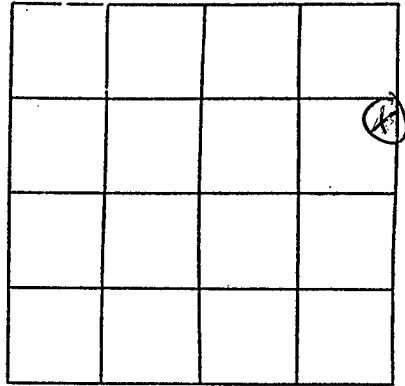

SECTION 12

Please indicate well location X.

Pump Capacity (GPM)	No. of Stages	Setting Depth
<u>85</u>		<u>140'</u> FT.

PUMP TEST

Well yielded _____ GPM with a drawdown of _____ ft. after _____ hours of pumping

LOG DATA

TYPE OF LOG RUN (Circle One): No Log Run, Electric, Gamma Ray, Density, Sonic, Neutron, Other (Describe) _____

Name of Organization Running Log _____

GEOLOGIC DATA (Office Use Only)

Surface Elev.	Geologic Unit	Unit Thickness	Depth to Top
Subs. SWL	Date	Analysis	Aquifer Test

Driller's Remarks

If more than one screen, show location of each on sketch.