

MISSISSIPPI DEPARTMENT OF ENVIRONMENTAL QUALITY
Office of Land and Water Resources

P. O. Box 10631
Jackson, MS 39289-0631
WATER WELL DRILLERS LOG

COUNTY WELL LOCATED <i>Walton</i>	
WELL NUMBER <i>D-87</i>	CODED
DATE WELL COMPLETED <i>3-26-04</i>	

PERMIT NUMBER
NAME OF DRILLING FIRM <i>P. Fitzgerald Well Service</i>

NAME & MAILING ADDRESS OF LANDOWNER <i>Chris Reed</i>			
<i>261 East Salem Rd.</i>			
Latitude:			
Longitude:			
WELL LOCATION:	SEC <i>4</i>	TOWNSHIP <i>3</i>	RANGE <i>11</i>
	<i>S</i>	<i>N</i>	<i>E</i>
DISTANCE <i>11</i> Miles	DIRECTION <i>North</i>	NEAREST TOWN <i>Tylerburg</i>	
OTHER LANDMARK			
WELL PURPOSE: <input checked="" type="radio"/> Home Irrigation, Municipal, Industrial, Fish Pond, etc.			

PUMP DATA		
PUMP TYPE (Circle One): <input checked="" type="radio"/> Submersible Turbine Jet Flowing Well, Other (Describe) _____		
POWER TYPE (Circle One): <input checked="" type="radio"/> Electric Tractor, Diesel, Gasoline, Butane, Other (Describe) _____ H/P <i>1/2"</i>		

DESCRIPTION OF FORMATIONS ENCOUNTERED	FROM	TO
<i>Clay</i>	<i>0</i>	<i>10</i>
<i>Sand</i>	<i>10</i>	<i>30</i>
<i>gravel</i>	<i>30</i>	<i>80</i>
<i>clay</i>	<i>80</i>	<i>90</i>
<i>sand</i>	<i>90</i>	<i>100</i>
<i>coarse sand,</i>	<i>100</i>	<i>118</i>

WELL DATA

Well Depth <i>118'</i>	Casing Diameter (In.) <i>4"</i>	Casing Length (Ft.) <i>108'</i>
Type of Casing <i>PVC</i>	Hole Depth <i>118'</i>	Depth to Static Water Level <i>68'</i>
TYPE OF COMPLETION: (Circle One or More): <input checked="" type="radio"/> Gravel Packed Underreamed, Telescoped, <input type="radio"/> Natural Development, Open Hole, Other (Describe) _____		
WELL GROUTED TO A DEPTH OF <i>10</i> FEET Type Grout (circle one): Cement, Bentonite, <input checked="" type="radio"/> Mix		

SCREEN DATA

Diameter - Inches <i>4"</i>	Length - Feet <i>10'</i>	Slot Size - Inches <i>.012</i>
Screen Type <i>PVC</i>	Depth to Bottom, Feet <i>118'</i>	

Top of Lap Pipe or Reduction in Casing		
FEET	IF TELESCOPED OR MORE THAN ONE SCREEN: USE BACK PAGE	

RECEIVED
APR 02 2004
DR. OLIVER

I certify that the well was drilled, constructed and completed in accordance with all applicable Requirements of the Mississippi Department of Environmental Quality and/or the Mississippi Department of Health regulations and state laws.


Bead Fitzgerald *029*
Signature of Licensed Driller and License No.

3-26-04
Date

Additional Information Required On Back

If well telescopes please sketch and show depths.

GROUND LEVEL

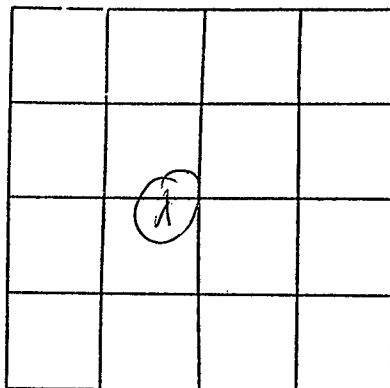

SECTION 4

Please indicate well location X.

Pump Capacity (GPM)	No. of Stages	Setting Depth	
12	8	110'	FT.

PUMP TEST

Well yielded _____ GPM with
 a drawdown of _____ ft.
 after _____ hours of pumping

LOG DATA

TYPE OF LOG RUN (Circle One): No Log Run, Electric, Gamma Ray, Density, Sonic, Neutron, Other (Describe) _____

Name of Organization Running Log

GEOLOGIC DATA (Office Use Only)

Surface Elev.	Geologic Unit	Unit Thickness	Depth to Top
Subs. SWL	Date	Analysis	Aquifer Test

Driller's Remarks

If more than one screen, show location of each on sketch.