

# State Well Report

## Part 1

Mississippi Department of Environmental Quality  
 Office of Land and Water Resources  
 P.O. Box 10631  
 Jackson, MS 39289-0631  
 (601)961-5210  
 (601)354-6938 (fax)

147  
For Office Use Only:

Aquifer: \_\_\_\_\_  
 Well #: D-92  
 L. S. Elevation: \_\_\_\_\_  
 E-log #: \_\_\_\_\_

County: Waltham  
 Permit #: \_\_\_\_\_  
 Driller: B Fitzgerald Well Serv  
 Date drilling completed: 8-4-04

State Law requires that this report be prepared by the driller in detail and filed with the Department within 30 days of completion of drilling of the well.

| Well Owner Information                    | Well Location  |
|---|--|
| Owner Name: <u>James m Gartin</u>         | Latitude: _____ Longitude: _____   |
| Mailing Address: <u>Tommy Rushing Rd.</u> | Method of Lat/Long (circle one): Conventional Survey, <u>USGS quad</u> , Hand-held GPS, Survey-grade GPS |
| <u>Tylertown</u> <u>ms.</u>               | <u>1/4</u> <u>1/4</u> Sec <u>3</u> Twn <u>3N</u> Rng <u>11E</u>  |
| City State Zip Code                       | Distance Direction Nearest Town  |
| Telephone No. (____) _____                | <u>3</u> Miles <u>NE</u> of <u>Salmon</u>  |

**Well Data**

Purpose of Well (circle one) Home Industrial Public Supply Irrigation Fish Culture Other: Poultry House

Date well drilling started: 8-4-04 Date well drilling completed: 8-4-04

If flowing, method of flow regulation: Valve \_\_\_\_\_ Other (describe) \_\_\_\_\_

Static Water Level: 55' feet above or below (circle one) land surface Date measured: 8-4-04

Method of Measurement (circle one) steel tape electric tape air line other: \_\_\_\_\_

Hole depth: 115' Well depth: 115' Well grouted to a depth of 10' feet

Type of grout (circle one): Cement Bentonite Mix

Casing length: 105' feet Casing diameter: 4" inches Type of casing: PVC

Screen length: 10' feet Screen diameter: 4" inches Type of screen: PVC

Screen slot size: .010 inches Setting depth: From 105' feet to 115' feet

Type of completion (circle all applicable): Gravel packed Underreamed Telescoped Open hole Natural Development

Other (describe): \_\_\_\_\_

Top of lap pipe or reduction in casing: \_\_\_\_\_ feet. If telescoped or more than one screen, describe on back of page

Logs run (circle all applicable): No log run Electric Gamma Ray Density Sonic Neutron Other: \_\_\_\_\_

Name of organization running log(s): \_\_\_\_\_

I certify that the well was drilled, constructed, and completed in accordance with all applicable requirements of the Mississippi Department of Environmental Quality and/or the Mississippi Department of Health regulations and state laws.

Bud Fitzgerald  
 Print Name of Water Well Contractor and License No. 029

Bud Fitzgerald  
 Signature of Water Well Contractor

RECEIVED  
 AUG 20 2004  
 BY: OLWR

If well telescopes please sketch below and show depths.


Ground Level

D-92


| Description of Formations Encountered | From | To  |
|---------------------------------------|------|-----|
| clay                                  | 0    | 20  |
| Sand & gravel                         | 20   | 60  |
| clay                                  | 60   | 70  |
| Sand                                  | 70   | 90  |
| course Sand & gravel                  | 90   | 115 |
|                                       |      |     |
|                                       |      |     |
If more than one screen, show location of each on sketch

Sketch the property layout and include the following: 1) the well location; 2) any permanent structures on the property that may aid in locating the well; 3) any roads, power lines, or other items that may aid in locating the property and the well; 4) indicate direction.

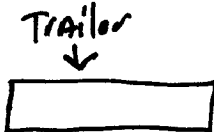

West

 

Tommy Rushing Rd.

East

Landowner Name: James McGaulin

*Bruce Steward*

Signature of Water Well Contractor

RECEIVED

AUG 20 2004

BY: OLWR

# STATE WELL REPORT

## Part 2

**Pump Installer's Completion Report**  
 Mississippi Department of Environmental Quality  
 Office of Land and Water Resources  
 P.O. Box 10631  
 Jackson, MS 39289-0631  
 (601)961-5210  
 (601)354-6938 (fax)

For Office Use Only:

Aquifer: \_\_\_\_\_

Well #: D-92

Elevation: \_\_\_\_\_

County: Waltham  
 Permit #: \_\_\_\_\_  
 Driller: \_\_\_\_\_  
 Date completed: 8-4-04

This report should be prepared by the pump installer in detail and filed with the Department within 30 days of the installation of pump.

| Well Owner Information                    | Well Location   |
|---|---|
| Owner Name: <u>James McGeehin</u>         | Latitude: _____ Longitude: _____                              |
| Mailing Address: <u>Tommy Rushing Rd.</u> | Method of Lat/Long (circle one): Conventional Survey,         |
| <u>Tylertown MS.</u>                      | USGS quad, Hand-held GPS, Survey-grade GPS                    |
| City State Zip Code                       | _____ 1/4 _____ 1/4 Sec <u>3</u> Twn <u>3N</u> Rng <u>11E</u> |
| Telephone No. (____) _____                | Distance Direction Nearest Town                               |
|   | <u>3</u> Miles <u>NE</u> of <u>Salem</u>                      |

| Pump Type<br>Circle one   | Power Type<br>Circle one                  |
|---|---|
| Air Lift Jet <input type="radio"/> <u>Submersible</u>                       | Diesel Engine Gasoline Engine Natural Gas |
| Bucket Piston <input type="radio"/> Turbine <input type="radio"/>           | <u>Electric Motor</u> Hand Tractor PTO    |
| Centrifugal Rotary <input type="radio"/> Flowing Well <input type="radio"/> | Windmill Other (specify): _____           |
| Other (specify): _____  | Horse Power Rating of Motor: <u>1/2</u>   |
| Date Pump Installed: <u>8-4-04</u>  | Setting Depth: <u>85</u> feet             |
| Rated Pump Capacity: <u>12</u> Gallons Per Minute                           | Number of Stages: <u>8</u>                |

| Pump Test Data   | Method of Measuring Water Level<br>Circle one                                     |
|--|---|
| Date Well Tested: _____                                | Air Line Electric Measuring Line <u>Steel Tape</u>                                |
| Static Water Level (A): _____ Feet Below Land Surface  | Other (specify): _____  |
| Pumping Water Level (B): _____ Feet Below Land Surface | For flowing well, measured shut in head: _____ feet                               |
| Drawdown [(B) - (A)]: _____ Feet Below Land Surface    | Well yielded _____ GPM with a drawdown of _____ feet after _____ hours of pumping |
| Test Pumping Rate: _____ Gallons Per Minute            |   |
| Duration of Pump Test (minimum 4 hours): _____ hours   |   |

I HEREBY CERTIFY that the above statements are true to the best of my knowledge.

Brad Fitzgerald 029  
 Print Name of Pump Installer and License No. (if applicable)

Brad Fitzgerald  
 Signature of Pump Installer

RECEIVED

AUG 20 2004

BY: OLWR