	State Well Report	•
	Part 1 – Driller's Log	For Office Use Only
Mississippi	i Department of Environmental Quality	Aquifer:
	ce of Land and Water Resources P.O. Box 10631	Well #:
Driller: Ertzgerahd hull Sure Date drilling completed: 4-24-07;	Jackson, MS 39289-0631	L. S. Elevation:
Date drilling completed:	(601)961-5210 (601)354-6938 (fax)	E-log #:
	-11	
State Law requires that this report be prepare Department at the above address within 30 d		
Information on Well Owner		rehole Location
(Landowner if borehole is not for a water we	Latitude: $31 \circ 13 \cdot 32$	" Longitude: 90. 1
Owner Name Lonnie Duncan-		
Mailing Address: Henen, Smith Rd,	Method of Lat/Long (circle on	, , , , , , , , , , , , , , , , , , ,
I	USGS quad, Hand-held	GPS, Survey-grade GPS
	1/4 1/4 Sec 1/8	
City State Zip	Code Distance Direction	Nearest Town
, , , , , , , , , , , , , , , , , , ,	Miles	of 7109 585
Telephone No. ()		0
Location of the source of any surface water used for dri Method of dosing and volume of Chlorine used in drill Logs run (circle all applicable): No log run Electric	ling and development:	
Location of the source of any surface water used for dri Method of dosing and volume of Chlorine used in drill Logs run (circle all applicable): No log run Electric	illing: ling and development: Gamma Ray Density Sonic Neutron	Other:
Location of the source of any surface water used for dri Method of dosing and volume of Chlorine used in drill Logs run (circle all applicable): No log run Electric Name of organization running log(s): Purpose of borehole (check one): Water WellGeote	illing: ling and development: Gamma Ray Density Sonic Neutron echnical/Geological Investigation Ground	Other: Source Heat Pump
Location of the source of any surface water used for dri Method of dosing and volume of Chlorine used in drill Logs run (circle all applicable): No log run Electric Name of organization running log(s): Purpose of borehole (check one): Water WellGeote Seismic SurveyOt	illing: ling and development: Gamma Ray Density Sonic Neutron	Other: Source Heat Pump
Location of the source of any surface water used for dri Method of dosing and volume of Chlorine used in drill Logs run (circle all applicable). No log run Electric Name of organization running log(5). Purpose of borehole (check one): Water Well Geote Seismic Survey Ot If drilling is not related to water we	illing:	Other: Source Heat Pump
Location of the source of any surface water used for dri Method of dosing and volume of Chlorine used in drill Logs run (circle all applicable). No log run Electric Name of organization running log(5). Purpose of borehole (check one): Water Well Geote Seismic Survey Ot If drilling is not related to water weat Purpose of Well (check one): Home Industrial I	illing: Gamma Ray Density Sonic Neutron echnical/Geological Investigation Ground ther (<i>describe</i>) <i>ll construction, skip the remainder of this bla</i> Public Supply Irrigation Fish Culture	Other: Source Heat Pump pck Other:
Location of the source of any surface water used for dri Method of dosing and volume of Chlorine used in drill Logs run (circle all applicable) No log run Electric Name of organization running log(5): Purpose of borehole (check one): Water WellGeote Seismic SurveyOt If drilling is not related to water wei Purpose of Well (check one): HomeIndustrialI If a flowing well, method of flow regulation: Valve	illing:	Other:
Location of the source of any surface water used for dri Method of dosing and volume of Chlorine used in drill Logs run (circle all applicable) No log run Electric Name of organization running log(5) Purpose of borehole (check one): Water Well Geote Seismic Survey Ot <u>If drilling is not related to water wei</u> Purpose of Well (check one): HomeIndustrialI If a flowing well, method of flow regulation: Valve Static Water Level: feet above or below	illing:	Other: Source Heat Pump pck Other: 4 - 24 - 24 - 27,
Location of the source of any surface water used for dri Method of dosing and volume of Chlorine used in drill Logs run (circle all applicable). No log run Electric Name of organization running log(5):Purpose of borehole (check one): Water WellGeote Seismic SurveyOt If drilling is not related to water well Purpose of Well (check one): HomeIndustrialI If a flowing well, method of flow regulation: Valve Static Water Level:feet above or below Method of Measurement (circle one)	illing:	Other: Source Heat Pump Other: 4-24-07;
Location of the source of any surface water used for dri Method of dosing and volume of Chlorine used in drill Logs run (circle all applicable). No log run Electric Name of organization running log(s):Purpose of borehole (check one): Water WellGeote Seismic SurveyOt If drilling is not related to water well Purpose of Well (check one): HomeIndustrialI If a flowing well, method of flow regulation: Valve Static Water Level:feet above or below Method of Measurement (circle one)feet fapt Well depth: Well grouted to a depth of	illing:	Other:
Location of the source of any surface water used for dri Method of dosing and volume of Chlorine used in drill Logs run (circle all applicable). No log run Electric Name of organization running log(s):Purpose of borehole (check one): Water WellGeote Seismic SurveyOt If drilling is not related to water well Purpose of Well (check one): HomeIndustrialI If a flowing well, method of flow regulation: Valve Static Water Level:feet above or below Method of Measurement (circle one)	illing:	Other:
Location of the source of any surface water used for dri Method of dosing and volume of Chlorine used in drill Logs run (circle all applicable): No log run Electric Name of organization running log(5). Purpose of borehole (check one): Water Well Geote Seismic SurveyOt If drilling is not related to water well Purpose of Well (check one): Home IndustrialI If a flowing well, method of flow regulation: Valve Static Water Level: feet above or below Method of Measurement (circle one) feet fap- Well depth: Well grouted to a depth of Casing length: feet Casing diameter:	illing:	Other:
Location of the source of any surface water used for dri Method of dosing and volume of Chlorine used in drill Logs run (circle all applicable). No log run Electric Name of organization running log(s):Purpose of borehole (check one): Water WellGeote Seismic SurveyOt If drilling is not related to water well Purpose of Well (check one): HomeIndustrialI If a flowing well, method of flow regulation: Valve Static Water Level:feet above or below Method of Measurement (circle one)feet fapt Well depth:Well grouted to a depth of	illing:	Other:
Location of the source of any surface water used for dri Method of dosing and volume of Chlorine used in drill Logs run (circle all applicable): No log run Electric Name of organization running log(5): Purpose of borehole (check one): Water Well Geote Seismic SurveyOt <u>If drilling is not related to water wei</u> Purpose of Well (check one): HomeIndustrialI If a flowing well, method of flow regulation: Valve Static Water Level: feet above or below Method of Measurement (circle one) feet fape Well depth: Well grouted to a depth of Casing length: feet Casing diameter: Screen length: feet Screen diameter:	illing:	Other:
Location of the source of any surface water used for dri Method of dosing and volume of Chlorine used in drill Logs run (circle all applicable): No log run Electric Name of organization running log(5): Purpose of borehole (check one): Water Well Geote Seismic SurveyOt If drilling is not related to water well Purpose of Well (check one): HomeIndustrialI If a flowing well, method of flow regulation: Valve Static Water Level: feet above or below Method of Measurement (circle one) feet tape Well depth: Well grouted to a depth of Casing length: feet Casing diameter: Screen length: feet Screen diameter: Screen slot size: inches Setting de Type of completion (circle all applicable): Gravel pace	illing:	Other: Source Heat Pump Source Heat Pump Other: Other: Uther: Uther:

Ý

Form: OLWR-SWR-1A

.

MAY 1 4 2007 BY: OLW R

D-107


Description of formations encountered must be provided for all

The sketch below only required for water wells

.

	wells and boreholes, unless specificall	wells and boreholes, unless specifically exempted by regulations				
<u>f well telescopes, show depths on sketch.</u> Ground Level	Description of Formations Encountered	From (depth)	To (depth)			
		Ground Level				
1	cluy,	0	20			
	S Guid. 1	20	60			
	craul.	60	80			
	Jelup	00	100			
	Chuy'	100	130			
	Suhd-	130	150			
	(urse sand	150	125			
			+			
		_				
		1	1			

If more than one screen, show location of each on sketch

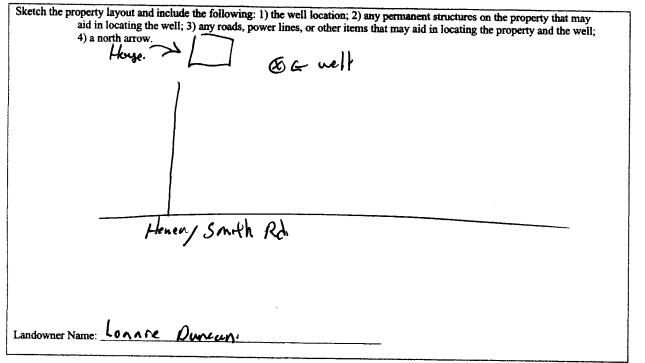

Form: OLWR-SWR-1A

I certify that the well/borehole was drilled, constructed, and completed in accordance with all applicable requirements of the Mississippi Department of Environmental Quality and the Mississippi Department of Health regulations, if applicable, and state

Date

laws. Brud Fitzgerald,

024, 4-24-07.

Print Name of Responsible Licensee and License No.

Signature of Licensee

RECEIVED MAY 1 4 2007 BY: OLWF

	STATE WI	ELL REPORT		
County: <u>Lafthan</u> Permit #: Driller: <u>FitZfrald</u> <u>Well</u> <u>Serve</u> Date completed: <u>Y124-07</u> . <u>Copy information from block on Part 1</u> This part of the report must be completed report must be attached and both parts fil Well Owner Informa Owner Name: <u>Due Lonnie</u> <u>Due</u> Mailing Address: <u>Henery</u> <u>Sourf</u>	P Pump Installer' Mississippi Department Office of Land P.O. 1 Jackson, N (601) (601)35 by a licensed water well led with the Department of tion	art 2 s Completion Report at of Environmental Quality and Water Resources Box 10631 AS 39289-0631 1961-5210 4-6938 (fax) contractor or a licensed pump at the above address within 30 d We Latitude: <u>31° 13' 32.</u>	For Office Use Only: Aquiver: Well #:	the
Tylestown mS City State	Zip Code	Distance Direction		
Pump Type Circle one	<u></u>	1	ower Type	
Air Lift Jet	Submersible)		Circle one Natural (ias
Bucket Piston	Turbine	Electric Motor Hand	U	
Centrifugal Rotary	Flowing Well		(specify):	
Other (specify):			r:	
Date Pump Installed: 424 -07,		Setting Depth: J 3 0		-
Rated Pump Capacity: 20		Number of Stages:		
Pump Test Data		1	easuring Water Level Circle one	
Date Well Tested:Feet Static Water Level (A):Feet Pumping Water Level (B):Feet	t Below Land Surface		asuring Line Steel Tape	
Drawdown [(B) - (A)]:Feet	Below Land Surface	For flowing well, measured s	shut in head:f	eet
Test Pumping Rate:	_Gallons Per Minute	Well yielded	GPM with a drawdown of	
Duration of Pump Test (minimum 4 hours)	:bours	feet after	hours of pump	ing
I HEREBY CERTIFY that the above states Brad Fitzfeve H Print Name of Pump Installer and License	024.	of my knowledge. Ben Hype Signature of Pump I	Form: OLWR-S	EIVE WR-1B 1 4 2007

/ : '

BY: OLWR