

SALTHALL

MISSISSIPPI BOARD OF WATER COMMISSIONERS

2-18-66

D 3001

WATER WELL DRILLERS LOG

Date: 2-18, 1966, Driller: J. T. Conroy, County: Pike


(1) Owner of Land: Dale Martin
(Name)
Tylertown, Miss.
(Address)
7 3/4 NE 1/4
(2) Location: 1/4, 1/4, Sec. T. 7 R. 10
8 miles North, of Tylertown
(distance) (direction) (Nearest Town)
(3) Topography: Hilly
(Hilly) (Flat) (Level)
(4) Purpose of Well: Domestic
(Domestic Irrigation, Municipal, Industrial, Other)

Description & Color of Materials Sand, Clay, Red Clay, Shell, etc.	Thick- ness Feet	Depth Feet
Sandy Clay	20	20
Sand & Rock	25	45
Chalk & Sand	10	55
Sand & Shovel	14	69

Information upon completion of well:

(1) Diameter 4" inches.
(2) Total Depth 69' feet.
(3) Water Level 55' feet below top of ground.
(4) Cased to 69', Size 4"
(5) Screen: Size 4", Length 6'
(6) Were any formations sealed against pollution?
yes, no.

If YES depth of formation _____
Why _____
Drillers Remarks: _____

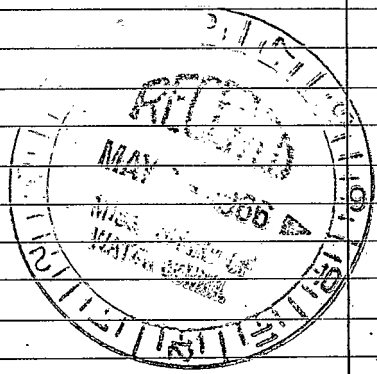

(Use Back Side)

Well No.

