

WALTHALL

10D 2002

6-67

MISSISSIPPI  
 BOARD OF WATER COMMISSIONERS  
 416 North State Street  
 Jackson, Mississippi 39201

WATER WELL DRILLERS LOG

6-7 1967 Thompson & Fails Walthall  
 date well completed firm name county well located

LANDOWNER: Don Holmes  
#2 Lytleton, Miss.  
 (mailing address)

description of formations encountered	from	to
<u>Clay</u>	<u>0</u>	<u>90</u>
<u>Gravel</u>	<u>90</u>	<u>122</u>
<u>Pea Gravel</u>	<u>122</u>	<u>152</u>

WELL LOCATION:  
 sec. 19 T. 30 S. R. 11 E.  
4 1/2 miles N 40 of Kokomo  
 (distance) (direction) (nearest town)


WELL PURPOSE: home  
 (home, irrigation, municipal, industrial)

WELL COMPLETION DATA:

- (1) diameter (inches) 2
- (2) total depth (feet) 152
- (3) static water level (feet) 30 (below above top of ground.)
- (4) casing Gal. 1491  
(material) (depth)  
 if telescope see back.
- (5) screen 31 1491  
(length) (depth to top)  
010 Stanley Steel  
(size) (material)
- (6) pump 1/2   
(HP) (yield gpm)  
Elect  
(type power)
- (7) electric log no  
(yes or no)  
  
(organization running log)
- (8) how well bottom plugged Back  
wash valve

*Identify correct County.*

*according to the given location, this well should be in Marion Co.*

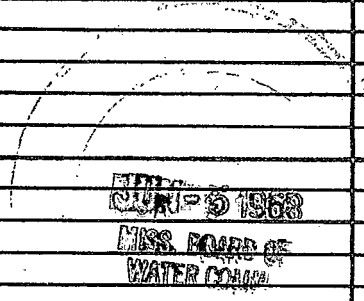


APR 5 1968  
 MISS. BOARD OF WATER COMMISSIONERS

DRILLERS REMARKS:

If well telescopes please sketch and show depths.

GROUND LEVEL

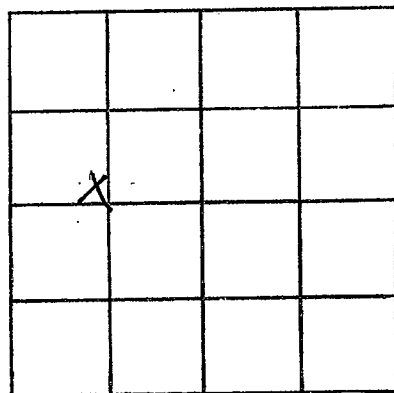

SECTION 19

Please indicate well location X.

ADDITIONAL INFORMATION

If more than one screen,  
show locations of each on sketch.