

Walthall
 D. 1004
 9/4/76

MISSISSIPPI
 BOARD OF WATER COMMISSIONERS
 416 North State Street
 Jackson, Mississippi 39201

WATER WELL DRILLERS LOG

Sept 4 1976 Reuser Well for Walthall
 date well completed firm name county well located

LANDOWNER:
 Lonnie Duncan
 Rt. 1 Syltoman
 (mailing address)

description of formations encountered	from	to
Red Clay	0	18
Red sand	18	90
gravel & sand	90	100
fine sandy loam	100	165
coarse gravel & small pe gravel	165	183

WELL LOCATION:
 sec. 18 T. 3 N R. 12 E
 4 1/2 miles EAST of Saline
 (distance) (direction) (nearest town)

WELL PURPOSE: home
 (home, irrigation, municipal, industrial)

WELL COMPLETION DATA:
 (1) diameter (inches) 4"
 (2) total depth (feet) 183
 (3) static water level (feet) 100 below top of ground.
 (4) casing plastic bottom (material) (depth)
 (size) if telescope see back.
 (5) screen 10' (length) 173 (depth to top)
 4" (size) plastic (material)
 (6) pump 3/4 HP (HP) 12 (yield gpm)
 elect (type power)
 (7) electric log no (yes or no)
 (organization running log)

(8) how well bottom plugged
 Wooden plug
 DRILLERS REMARKS:


RECEIVED

NOV 15 1976

MISS. BD. OF WATER COMMISSIONERS

If well telescopes please sketch and show depths.

GROUND LEVEL

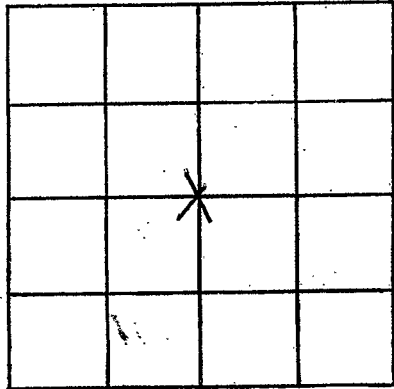

SECTION 18

Please indicate well location X.

ADDITIONAL INFORMATION

If more than one screen, show locations of each on sketch.