

WALTHALL
D 2005
8/16/76

MISSISSIPPI
 BOARD OF WATER COMMISSIONERS
 416 North State Street
 139 Jackson, Mississippi 39201

WATER WELL DRILLERS LOG

8-16
 date well completed

1976 Felguswell Drilling Co
 firm name

Walthall
 county well located


LANDOWNER:	description of formations encountered	from	to
<u>E. J. Holmes</u>			
<u>P.R. Lybourn</u> (mailing address)	<u>Red clay</u>	<u>0</u>	<u>20</u>
	<u>Red sand</u>	<u>20</u>	<u>60</u>
	<u>White + Blue chalk</u>	<u>60</u>	<u>145</u>
	<u>Coarse sand & gravel</u>	<u>145</u>	<u>155</u>
WELL LOCATION: sec. <u>7</u> T. <u>3</u> N. R. <u>18</u> E. <u>9</u> miles <u>NE</u> of <u>Lybourn</u> (distance) (direction) (nearest town)			
WELL PURPOSE: (home, irrigation, municipal, industrial) <u>Home</u>			
WELL COMPLETION DATA: (1) diameter (inches) <u>4</u>			
(2) total depth (feet) <u>155</u>			
(3) static water level (feet) <u>75</u> below above top of ground.			
(4) casing <u>PVC</u> , <u>147</u> (material) (depth) <u>4</u> (size) if telescope see back.			
(5) screen <u>8</u> , <u>147</u> (length) (depth to top) <u>4</u> (size) <u>PVC</u> (material)			
(6) pump <u>1/2</u> , <u>10</u> (HP) (yield gpm) <u>elec</u> (type power)			
(7) electric log <u>no</u> (yes or no) (organization running log)			
(8) how well bottom plugged <u>Sand block</u>			
DRILLERS REMARKS:			

RECEIVED

AUG 20 1976

If well telescopes please sketch and show depths.

GROUND LEVEL

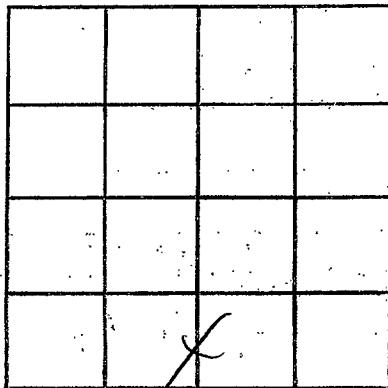

SECTION 7

Please indicate well location X.

ADDITIONAL INFORMATION

If more than one screen,
show locations of each on sketch.