

WALTHALL

D 2006

12-8-75

MISSISSIPPI
 BOARD OF WATER COMMISSIONERS
 416 North State Street
 Jackson, Mississippi 39201

WATER WELL DRILLERS LOG

Dec-8
date well completed

130
25 Reun Well Ser
firm name

Walthall
county well located


LANDOWNER:	description of formations encountered	from	to
Albie Piggott Rt. 1 Tylertown (mailing address)			
WELL LOCATION: sec 29 T 3 N R 11 E 5 miles south of Tylertown (distance) (direction) (nearest town)			
WELL PURPOSE: <u>Residential</u> (home, irrigation, municipal, industrial)			
WELL COMPLETION DATA: (1) diameter (inches) <u>4 1/2"</u> (2) total depth (feet) <u>120</u> (3) static water level (feet) <u>64</u> below top of ground. (4) casing <u>plastic bottom</u> (material) (depth) (5) screen <u>6"</u> <u>1 1/4"</u> (length) (depth to top) <u>4"</u> <u>plastic</u> (size) (material) (6) pump <u>3/4 HP</u> <u>6</u> (type power) (yield gpm) (7) electric log <u>no</u> (organization running log)			
DRILLERS REMARKS: <u>cell well went</u> <u>dry</u>			

RECEIVED
 JAN 28 1976

MISSISSIPPI BOARD OF WATER COMMISSIONERS

If well telescopes please sketch and show depths.

GROUND LEVEL

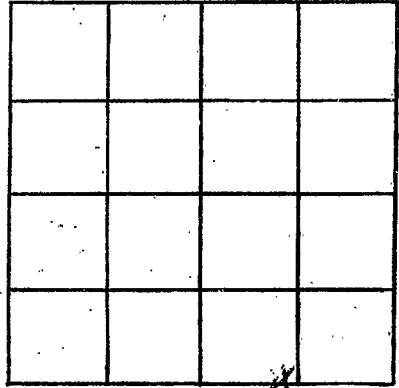

SECTION 29

Please indicate well location X.

ADDITIONAL INFORMATION

If more than one screen, show locations of each on sketch.