

WALTHALL

D 2007

2-20-76

MISSISSIPPI
 BOARD OF WATER COMMISSIONERS
 416 North State Street
 1301 Jackson, Mississippi 39201

WATER WELL DRILLERS LOG

20 Feb 1976
date well completed

firm name

county well located

Amos Lake Well Drilling Walthall

LANDOWNER:

Frank Kennedy

Tylertown Miss.
(mailing address)

WELL LOCATION:

sec 32 T 3 N R 11 E

5 miles N of Tylertown
(distance) (direction) (nearest town)

WELL PURPOSE:

(home, irrigation, municipal, industrial)

WELL COMPLETION DATA:

- (1) diameter (inches) 4
- (2) total depth (feet) 114
- (3) static water level (feet) 75 below above top of ground.

(4) casing PI, 108
(material) (depth)

(size) If telescope see back.

(5) screen 6, 108
(length) (depth to top)

4, PI
(size) (material)

(6) pump 1/2, 8
(HP) (yield gpm)

elect
(type power)

(7) electric log (yes or no)

(organization running log)

(8) how well bottom plugged wood

description of formations encountered

from

to

<i>clay</i>	<i>0</i>	<i>75</i>
<i>red sand shale</i>	<i>75</i>	<i>65</i>
<i>sand</i>	<i>65</i>	<i>75</i>
<i>chert sand</i>	<i>75</i>	<i>85</i>
<i>sand</i>	<i>85</i>	<i>114</i>

DRILLERS REMARKS:




APR 20 1976

NO. OF WATER COMPI

If well telescopes please sketch and show depths.

GROUND LEVEL

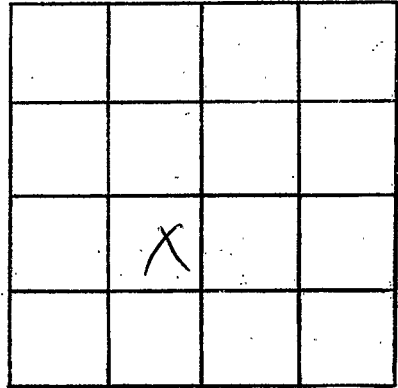

SECTION 32

Please indicate well location X.

ADDITIONAL INFORMATION

If more than one screen, show locations of each on sketch.