

Walshall
 D 2008
 9/15/76

MISSISSIPPI
 BOARD OF WATER COMMISSIONERS
 416 North State Street
 Jackson, Mississippi 39201

134

WATER WELL DRILLERS LOG

Sept 15 1976 Reynolds Well Co. Walshall
 date well completed firm name county well located


LANDOWNER:	description of formations encountered	from	to
<u>Lavern M. Knight</u> <u>PO 3 Joplin</u> (mailing address)	<u>Red clay</u> <u>Red sand</u> <u>sand & pea gravel</u>	<u>0</u> <u>10</u> <u>60</u>	<u>10</u> <u>60</u> <u>102</u>
WELL LOCATION:			
sec. <u>12</u> T. <u>3</u> N R. <u>4</u> E <u>8</u> miles <u>North E</u> of <u>Joplin</u> (distance) (direction) (nearest town)			
WELL PURPOSE: <u>Home</u> (home, irrigation, municipal, industrial)			
WELL COMPLETION DATA:			
(1) diameter (inches) <u>4"</u>			
(2) total depth (feet) <u>102</u>			
(3) static water level (feet) <u>70</u> below above top of ground.			
(4) casing <u>plastic bottom</u> (material) (depth)			
_____ if telescope see back. (size)			
(5) screen <u>6"</u> <u>96</u> (length) (depth to top)			
_____ <u>plastic</u> (size) (material)			
(6) pump <u>1/2</u> <u>10</u> (HP) (yield gpm)			
<u>electric</u> (type power)			
(7) electric log <u>NO</u> (yes or no)			
_____ (organization running log)			
(8) how well bottom plugged <u>with sand plug</u>			
DRILLERS REMARKS:			

RECEIVED
 DEC 8 1976

MISS. BD. OF WATER COMMISSIONERS

If well telescopes please sketch and show depths.

GROUND LEVEL

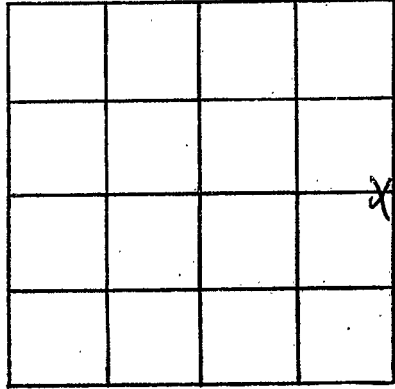

SECTION 12

Please indicate well location X.

ADDITIONAL INFORMATION

If more than one screen, show locations of each on sketch.