

Walthall  
D 2005  
7/30/76

MISSISSIPPI  
 BOARD OF WATER COMMISSIONERS  
 416 North State Street  
 Jackson, Mississippi 39201

WATER WELL DRILLERS LOG

7-30 1976 Ferguson Well Service Walthall  
 date well completed firm name county well located

LANDOWNER:  
Happy Smith  
R.R. by letter to Miss.  
 (mailing address)

description of formations encountered	from	to
<u>Red clay</u>	<u>0</u>	<u>20</u>
<u>Red sand</u>	<u>20</u>	<u>70</u>
<u>Coarse sand gravel</u>	<u>70</u>	<u>100</u>

WELL LOCATION:  
 sec. 25 T. 3 N. R. 16 E  
 S W  
8 miles NE of \_\_\_\_\_  
 (distance) (direction) (nearest town)

WELL PURPOSE:  
 (home, irrigation, municipal, industrial)

- WELL COMPLETION DATA:
- (1) diameter (inches) 4
  - (2) total depth (feet) 100
  - (3) static water level (feet) 50 below above top of ground.
  - (4) casing PVC, 92,  
 (material) (depth)  
4 If telescope see back.  
 (size)
  - (5) screen 8, 92  
 (length) (depth to top)  
4, PVC  
 (size) (material)
  - (6) pump 3/4, 15  
 (HP) (yield gpm)  
Electric  
 (type power)
  - (7) electric log Yes  
 (yes or no)  
 (organization running log)
  - (8) how well bottom plugged Sand block

DRILLERS REMARKS:


**RECEIVED**

AUG 20 1976

MISS. BD. OF WATER COMMISSIONERS

If well telescopes please sketch and show depths.

GROUND LEVEL

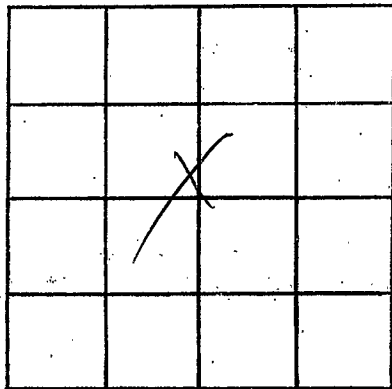

SECTION 25

Please indicate well location X.

ADDITIONAL INFORMATION

If more than one screen, show locations of each on sketch.