

WALTHALL  
D 2010  
3/176

MISSISSIPPI  
 BOARD OF WATER COMMISSIONERS  
 416 North State Street  
 Jackson, Mississippi 39201

WATER WELL DRILLERS LOG

March 1976 date well completed      E.B. Sherrard Walthall firm name      county well located


LANDOWNER:	description of formations encountered	from	to
<u>Jerry Bergeron</u> <u>Dyersburg, Miss</u> (mailing address)	<u>GRAY CLAY</u> <u>MIXED GRAVEL</u> <u>+ SAND + CLAY</u> <u>SAND + GRAVEL</u>	<u>0</u>   <u>25</u>   <u>65</u>   <u>85</u>	<u>25</u>   <u>65</u>   <u>85</u>
<b>WELL LOCATION:</b> sec. <u>11</u> T. <u>3</u> N. R. <u>11</u> E. <u>S</u> <u>W</u> <u>10</u> miles <u>NE</u> <u>Dyersburg</u> (distance) (direction) (nearest town)			
<b>WELL PURPOSE:</b> (home, irrigation, municipal, industrial)			
<b>WELL COMPLETION DATA:</b> (1) diameter (inches) <u>2"</u> (2) total depth (feet) <u>85'</u> (3) static water level (feet) <u>40'</u> <input checked="" type="checkbox"/> below top of ground. (4) casing <u>pl.</u> <u>80'</u> (material) (depth) <u>2"</u> if telescope see back. (size) (5) screen <u>5'</u> (length) (depth to top) <u>2"</u> <u>pl.</u> (size) (material) (6) pump <u>1</u> <u>7</u> (HP) (yield gpm) <u>elec.</u> (type power) (7) electric log <input checked="" type="checkbox"/> (yes or no) (organization running log) (8) how well bottom plugged <u>BWV</u>			
<b>DRILLERS REMARKS:</b>			

**RECEIVED**  
 OCT 18 1976

MISS. BD. OF WATER COMMISSIONERS

If well telescopes please sketch and show depths.

GROUND LEVEL

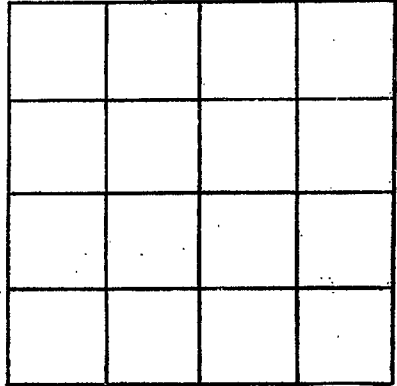

SECTION: \_\_\_\_\_

Please indicate well location X.

ADDITIONAL INFORMATION

A series of horizontal lines for recording additional information, starting below the 'ADDITIONAL INFORMATION' header and extending to the bottom of the page.

If more than one screen, show locations of each on sketch.