

Walthall  
 D 2013  
 3/17/76

MISSISSIPPI  
 BOARD OF WATER COMMISSIONERS  
 416 North State Street  
 Jackson, Mississippi 39201

WATER WELL DRILLERS LOG

March 17 1976 Remus Miller Walthall  
 date well completed firm name county well located

LANDOWNER:  
L. L. James  
P. F. D. Lyletown  
 (mailing address)

description of formations encountered	from	to
<u>Red Clay</u>	<u>0</u>	<u>16</u>
<u>Red sand</u>	<u>16</u>	<u>58</u>
<u>sand &amp; gravel</u>	<u>58</u>	<u>80</u>

WELL LOCATION:  
 sec 21 T 3 N R 11 E  
3 miles SSE of Salem  
 (distance) (direction) (nearest town)

WELL PURPOSE: Home  
 (home, irrigation, municipal, industrial)

- WELL COMPLETION DATA:
- (1) diameter (inches) 4"
  - (2) total depth (feet) 80
  - (3) static water level (feet) 56 below top of ground
  - (4) casing plastic, bottom  
 (material) (depth)
  - if telescope see back.  
 (size)
  - (5) screen 6' 74'  
 (length) (depth to top)
  - 4 plastic  
 (size) (material)
  - (6) pump 1/2 Sub 10  
 (HP) (yield gpm)
  - elect  
 (type power)
  - (7) electric log no  
 (yes or no)
- (organization running log)


(8) how well bottom plugged:  
wooden plug

DRILLERS REMARKS:  
no remarks

MISS. BOARD OF WATER COMMISSIONERS  
 JUN - 8 1976

If well telescopes please sketch and show depths.

GROUND LEVEL

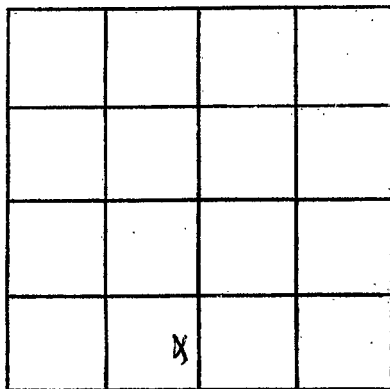

SECTION 21

Please indicate well location X.

ADDITIONAL INFORMATION

If more than one screen, show locations of each on sketch.