

Walthall
 D 2014
 5/28/76

MISSISSIPPI
 BOARD OF WATER COMMISSIONERS
 416 North State Street
 Jackson, Mississippi 39201

WATER WELL DRILLERS LOG

May 28 1976 *Reeves Well Ser* Walthall
 date well completed firm name county well located

LANDOWNER:
St. John Church (no 2)
R. F. D. Ffestetown
 (mailing address)

description of formations encountered	from	to
	<i>Red Clay</i>	<i>@ 15</i>
<i>Red sand</i>	<i>15</i>	<i>50</i>
<i>Chalky lobbly</i>	<i>50</i>	<i>80</i>
<i>sand & pea gravel</i>	<i>80</i>	<i>103</i>

WELL LOCATION:
 sec. *29* T. *3* N. R. *22* E
3 miles *S-SW* of *Salem*
 (distance) (direction) (nearest town)

WELL PURPOSE: *church*
 (home, irrigation, municipal, industrial)

WELL COMPLETION DATA:

(1) diameter (inches) *4"*

(2) total depth (feet) *103*

(3) static water level (feet) *65* below above top of ground.

(4) casing *plastic bottom*
 (material) (depth)
 (size) If telescope see back.

(5) screen *6"* *97*
 (length) (depth to top)
4" *plastic*
 (size) (material)

(6) pump *1/2* *10*
 (HP) (yield-gpm)
elect
 (type power)

(7) electric log *no*
 (yes or no)

(organization running log)

(8) how well bottom plugged
no bottom plug

DRILLERS REMARKS:
no remark


RECEIVED

AUG 20 1976

MISS. BD. OF WATER COMM

If well telescopes please sketch and show depths.

GROUND LEVEL

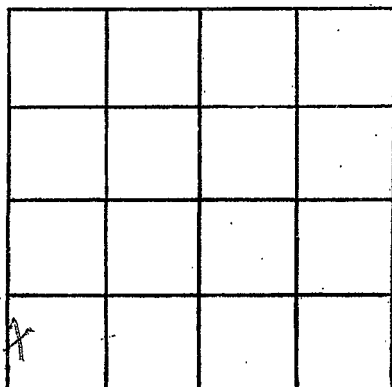

SECTION 29

Please indicate well location X.

ADDITIONAL INFORMATION

If more than one screen,
show locations of each on sketch.