

WALTHALL
D JAS
5/20/77

MISSISSIPPI
 BOARD OF WATER COMMISSIONERS
 416 North State Street
 13U Jackson, Mississippi 39201

46

WATER WELL DRILLERS LOG

May-20 1977 *Penner Well Drilling Walthall*
 date well completed firm name county well located

LANDOWNER:
Mr. Clifford Holmes
Rt 1 Kokomo 39643
 (mailing address)

| description of formations encountered | from to | |
|---------------------------------------|------------|------------|
| | | |
| <i>Red Clay</i> | <i>0</i> | <i>12</i> |
| <i>Sand</i> | <i>12</i> | <i>40</i> |
| <i>Miss. Sand & Gravel</i> | <i>40</i> | <i>77</i> |
| <i>White Chalk</i> | <i>77</i> | <i>100</i> |
| <i>Pea gravel & sand</i> | <i>100</i> | <i>117</i> |

WELL LOCATION:
 sec. 1 T. 3 N R. 11 E
1 1/2 miles South of Darhur
 (distance) (direction) (nearest town)

WELL PURPOSE: home
 (home, irrigation, municipal, industrial)

WELL COMPLETION DATA:

(1) diameter (inches) 4"

(2) total depth (feet) 117

(3) static water level (feet) 85 below top of ground.

(4) casing plastic bottom
 (material) (depth)

 if telescope see back.
 (size)

(5) screen 5' 112'
 (length) (depth to top)

4' plastic
 (size) (material)

(6) pump bothers
 (HP) (yield gpm)

slut
 (type power)

(7) electric log no
 (yes or no)

 (organization running log)


(8) how well bottom plugged
wooden plug

DRILLERS REMARKS:
all well went
by

RECEIVED
 AUG 20 1977

If well telescopes please sketch and show depths.

GROUND LEVEL

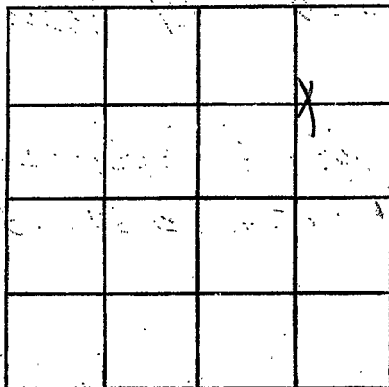

SECTION 1

Please indicate well location X.

ADDITIONAL INFORMATION

If more than one screen, show locations of each on sketch.