

WALTHALL
D 2016
JUNE 28, 1977

MISSISSIPPI
 BOARD OF WATER COMMISSIONERS
 416 North State Street
 132a Jackson, Mississippi 39201

WATER WELL DRILLERS LOG

June: 28 19 77 Covington WALTHALL
 date well completed firm name county well located

LANDOWNER: Claude Holmes
(contractor)
Tubston
 (mailing address)

description of formations encountered	from	to
<u>CLAY</u>	<u>0</u>	<u>16</u>
<u>SAND</u>	<u>16</u>	<u>24</u>
<u>CLAY</u>	<u>24</u>	<u>78</u>
<u>PACKY SAND</u>	<u>78</u>	<u>116</u>
<u>SAND</u>	<u>116</u>	<u>134</u>

WELL LOCATION:
 sec. 10 T. 3 N R. 11 E
 S W
1 1/2 miles E of SABON
 (distance) (direction) (nearest town)

WELL PURPOSE: HOME
 (home, irrigation, municipal, industrial)


- WELL COMPLETION DATA:
- (1) diameter (inches) 4"
 - (2) total depth (feet) 134'
 - (3) static water level (feet) 109' below top of ground.
 - (4) casing PLASTIC 124'
 (material) (depth)
4" if telescope see back.
 (size)
 - (5) screen 10' 124'
 (length) (depth to top)
4" PLASTIC
 (size) (material)
 - (6) pump 1/2 10
 (HP) (yield gpm)
 (type power)
 - (7) electric log no
 (yes or no)
 (organization running log)
 - (8) how well bottom plugged Wood

DRILLERS REMARKS:

RECEIVED
 AUG 10 1977

If well telescopes please sketch and show depths.

GROUND LEVEL

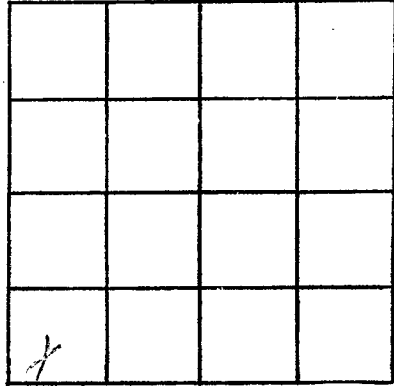

SECTION 13

Please indicate well location X.

ADDITIONAL INFORMATION

If more than one screen, show locations of each on sketch.