

WALTHALL

D 207

4-13-77

MISSISSIPPI BOARD OF WATER COMMISSIONERS 416 North State Street 137 Jackson, Mississippi 39201

WATER WELL DRILLERS LOG

4-13

19

77 Fitzgerald Well Serv

firm name

Walthall

county well located

LANDOWNER:

Charles Boyd

RR Lytleton (mailing address)

description of formations encountered

from

to

Red Clay

0

22

Red Sand

20

118

Coarse sand & gravel

118

128

WELL LOCATION:

sec. 8 T. 3 N R. 11 E

2 miles NE of Selma (distance) (direction) (nearest town)

WELL PURPOSE:

Home (home, irrigation, municipal, industrial)

WELL COMPLETION DATA:

- (1) diameter (inches) 4
(2) total depth (feet) 128
(3) static water level (feet) 80 below top of ground.
(4) casing PVC 120 (material) (depth) 4 (size) if telescope see back.
(5) screen 8 120 (length) (depth to top) 4 PVC (size) (material)
(6) pump 1/2 10 (HP) (yield gpm) Electric (type power)
(7) electric log no (yes or no)
(organization running log)
(8) how well bottom plugged Seal Shk


RECEIVED

JUL 5 1977

DRILLERS REMARKS:

If well telescopes please sketch and show depths.

GROUND LEVEL

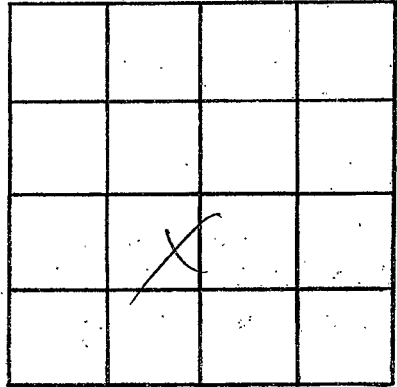

SECTION 48

Please indicate well location X.

ADDITIONAL INFORMATION

If more than one screen,
show locations of each on sketch.