

WATHALL
 D 2018
 4-1-77

MISSISSIPPI
 BOARD OF WATER COMMISSIONERS
 416 North State Street
 1324 Jackson, Mississippi 39201

WATER WELL DRILLERS LOG

4/1 1977 Hollinger Water Well Wathall
 date well completed firm name county well located

LANDOWNER:	description of formations encountered	from	to
Penacostal Church of God			
General H. L. Lyntown (mailing address)	CLAY SAND, gravel	0	60

WELL LOCATION:
 sec. 27 T. 3 N. R. 11 E
 5 1/2 miles N.W. of KOKOMO
 (distance) (direction) (nearest town)

WELL PURPOSE: Church
 (home, irrigation, municipal, industrial)


- WELL COMPLETION DATA:
- (1) diameter (inches) 2"
 - (2) total depth (feet) 120
 - (3) static water level (feet) 60 ^{below} above top of ground.
 - (4) casing PVC, 115' (material) (depth)
 (size) if telescope see back.
 - (5) screen 5' 115' (length) (depth to top)
 2" PVC (size) (material)
 - (6) pump 1 HP 7 (yield gpm)
 elect (type power)
 - (7) electric log (yes or no)
- (organization running log)
- (8) how well bottom plugged sand silt/clay

DRILLERS REMARKS: good well

RECEIVED
 APR 26 1977
 MISS. BD. OF WATER COMMISSIONERS

If well telescopes please sketch and show depths.

GROUND LEVEL

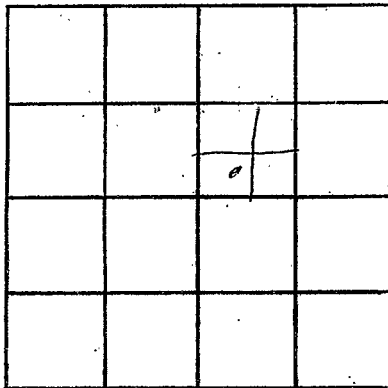

SECTION 27

Please indicate well location X.

ADDITIONAL INFORMATION

If more than one screen,
show locations of each on sketch.