

WALTHALL
 D 205
 4-7-77

MISSISSIPPI
 BOARD OF WATER COMMISSIONERS
 416 North State Street
 1326 Jackson, Mississippi 39201

(27)

WATER WELL DRILLERS LOG

April 7, 1977 Burns well in Walthall
 date well completed firm name county well located

LANDOWNER:
 Versie Burns
 Rt 1 Tylertown
 (mailing address)

description of formations encountered	from	to
Red Clay	0	20
Red sand	20	32
Hard Chalk	32	70
lobbly	70	98
Coarse sand	98	112

WELL LOCATION:
 sec. 15 T-3 N R-11 E
 8 miles N-NE of Tylertown
 (distance) (direction) (nearest town)

WELL PURPOSE: miller
 (home, irrigation, municipal, industrial)

- WELL COMPLETION DATA:
- (1) diameter (inches) 4"
 - (2) total depth (feet) 112
 - (3) static water level (feet) 85 below top of ground.
 - (4) casing plastic bottom
 (material) (depth)
 - If telescope see back.
 (size)
 - (5) screen 6" 106
 (length) (depth to top)
 - 4" plastic
 (size) (material)
 - (6) pump 1/2 hp 10
 (HP) (yield gpm)
 - elect
 (type power)
 - (7) electric log no
 (yes or no)

 (organization running log)

(8) how well bottom plugged:
wooden plug


DRILLERS REMARKS:

RECEIVED
 APR 4 1977

MISS. BD. OF WATER COMM.

If well telescopes please sketch and show depths.

GROUND LEVEL

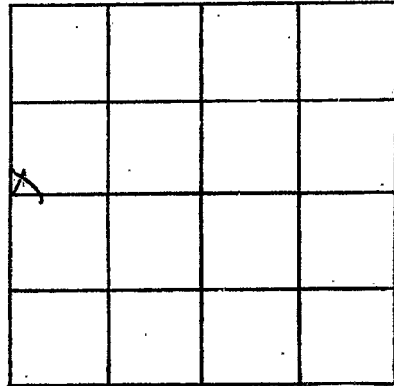

SECTION 15

Please indicate well location X.

ADDITIONAL INFORMATION

If more than one screen, show locations of each on sketch.