

WALTHALL

D 2020

6-28-77

MISSISSIPPI (75)
 BOARD OF WATER COMMISSIONERS
 416 North State Street
 Jackson, Mississippi 39201

WATER WELL DRILLERS LOG

June 28 1977 Reuss Miller Walthall
 date well completed firm name county well located

LANDOWNER:
Randy Mc Kenzie
Rt 3 Kyles town
 (mailing address)

description of formations encountered	from	to
<u>Red sandy clay</u>	<u>0</u>	<u>17</u>
<u>Red sand</u>	<u>17</u>	<u>60</u>
<u>lobbly sand</u>	<u>60</u>	<u>105</u>
<u>Coarse sand</u>	<u>105</u>	<u>123</u>

WELL LOCATION:
 sec. 22 T. 3 N R. 11 E
2.6 miles North of Kyles town
 (distance) (direction) (nearest town)

WELL PURPOSE: Home
 (home, irrigation, municipal, industrial)


- WELL COMPLETION DATA:
- diameter (inches) 4"
 - total depth (feet) 123 ft
 - static water level (feet) 80 below top of ground
 - casing plastic bottom
 (material) (depth)
 if telescope see back.
 (size)
 - screen 6' 117'
 (length) (depth to top)
4" plastic
 (size) (material)
 - pump 1/2 HP 10
 (HP) (yield gpm)
Electric
 (type power)
 - electric log no
 (yes or no)
 (organization running log)

(8) how well bottom plugged
Wooden plug
 DRILLERS REMARKS:
[Signature]

RECEIVED
 NOV 9 1977

If well telescopes please
sketch and show depths.

GROUND LEVEL

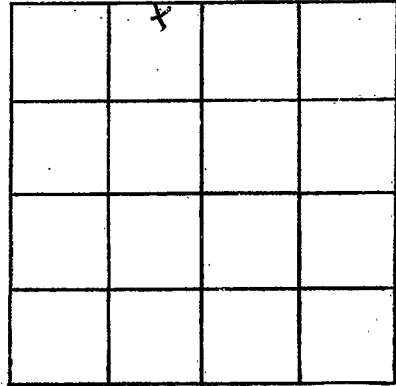

SECTION 22

Please indicate well location X.

ADDITIONAL INFORMATION

If more than one screen,
show locations of each on sketch.