

WALTHALL
 D 2021
 7-6-77

MISSISSIPPI
 BOARD OF WATER COMMISSIONERS
 416 North State Street
 1322 Jackson, Mississippi 39201

77

WATER WELL DRILLERS LOG

July 6 1977 Renewal in Walthall
 date well completed firm name county well located

LANDOWNER:
Mr. Donald Boyd
Rt 3 Jylitown
 (mailing address)

description of formations encountered	from	to
<u>Red Clay</u>	<u>0</u>	<u>12</u>
<u>Red sand</u>	<u>12</u>	<u>45</u>
<u>Permeable sand</u>	<u>45</u>	<u>78</u>

WELL LOCATION:
 sec. 17 T. 3 N R. 11 E
8.64 miles North of Jylitown
 (distance) (direction) (nearest town)

WELL PURPOSE: none
 (home, irrigation, municipal, industrial)

- WELL COMPLETION DATA:
- (1) diameter (inches) _____
 - (2) total depth (feet) 78
 - (3) static water level (feet) 45 below top of ground.
 - (4) casing plastic bottom
 (material) (depth)
 _____ if telescope see back.
 (size)
 - (5) screen 6" 72'
 (length) (depth to top)
4" plastic
 (size) (material)
 - (6) pump 1/2 HP 10
 (HP) (yield gpm)
chest
 (type power)
 - (7) electric log no
 (yes or no)

 (organization running log)

(8) how well bottom plugged
wooden plug


DRILLERS REMARKS:

RECEIVED
 NOV - 9 1977

MISS. BD. OF WATER COMMISSIONERS

If well telescopes please sketch and show depths.

GROUND LEVEL

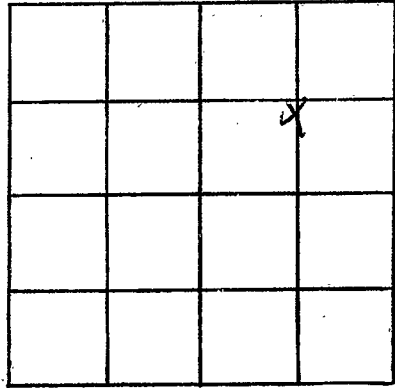

SECTION 17

Please indicate well location X.

ADDITIONAL INFORMATION

If more than one screen,
show locations of each on sketch.