

WALTHALL  
D 2002  
12/15/77

MISSISSIPPI  
BOARD OF WATER COMMISSIONERS  
416 North State Street  
Jackson, Mississippi 39201

WATER WELL DRILLERS LOG

Dec. 15 1977 77 Bromfield Well Sp. WALTHALL  
date well completed firm name county well located

LANDOWNER: Mamie JAMES  
Tylertown  
Miss  
(mailing address)

WELL LOCATION:  
sec. 21 T 3 N R 11 E  
7 miles N.W. of Tylertown  
(distance) (direction) (nearest town)

WELL PURPOSE: Home  
(home, irrigation, municipal, industrial)

WELL COMPLETION DATA:  
(1) diameter (inches) 4  
(2) total depth (feet) 111  
(3) static water level (feet) 19 below above top of ground.  
(4) casing Plastic 91 (material) (depth)  
4" if telescope see back. (size)  
(5) screen 16' 91 (length) (depth to top)  
4" Plastic (size) (material)  
(6) pump 1/2 7 (HP) (yield gpm)  
electric (type-power)  
(7) electric log no (yes or no)  
(organization running log)  
(8) how well bottom plugged Sandstone

description of formations encountered	from	to
CLAY	0	22
SANDY - CLAY	22	48
CLAY	48	66
CHALK Rock	66	79
SAND	79	99
SAND & ROCK	99	111


RECEIVED  
MAR 21 1978

DRILLERS REMARKS:

MISS. BD. OF WATER COMMISSIONERS

If well telescopes please sketch and show depths.

GROUND LEVEL

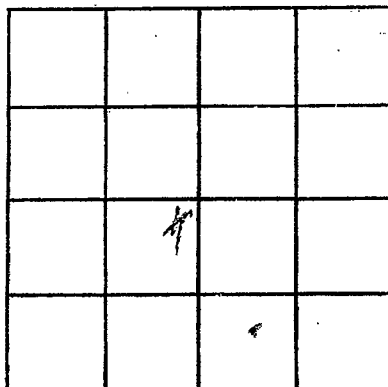

SECTION 21

Please indicate well location X.

ADDITIONAL INFORMATION

If more than one screen,  
show locations of each on sketch.