

WALTHALL  
 D 2023  
 2-2-77

MISSISSIPPI  
 BOARD OF WATER COMMISSIONERS  
 416 North State Street  
 Jackson, Mississippi 39201

9

WATER WELL DRILLERS LOG

Feb 2 1977 Blueswell Ken Walthall  
 date well completed firm name county well located

LANDOWNER:  
Jimmy McKenzie  
RT 1 Tylertown  
 (mailing address)

description of formations encountered	from	to
<u>Sandy clay</u>	<u>0</u>	<u>30</u>
<u>Red chalk</u>	<u>30</u>	<u>70</u>
<u>limestone</u>	<u>70</u>	<u>100</u>
<u>coarse sand</u>	<u>100</u>	<u>117</u>

WELL LOCATION:  
 sec. 15 T 3 N R 11 E  
8 miles N-NE of Tylertown  
 (distance) (direction) (nearest town)

WELL PURPOSE: home  
 (home, irrigation, municipal, industrial)

WELL COMPLETION DATA:  
 (1) diameter (inches) 4"  
 (2) total depth (feet) 117  
 (3) static water level (feet) 70 below top of ground.  
 (4) casing plastic bottom  
 (material) (depth)  
1 if telescope see back.  
 (size)  
 (5) screen 16" 10.2  
 (length) (depth to top)  
2 1/2" plastic  
 (size) (material)  
 (6) pump 1/2 1.0  
 (HP) (yield. gpm)  
1/2  
 (type power)  
 (7) electric log NO  
 (yes or no)  
 (organization running log)


(8) how well bottom plugged  
1/2" screen plug  
 DRILLERS REMARKS:

RECEIVED  
 FEB 18 1977

MISS. Bd. OF WATER COMMISSIONERS

If well telescopes please sketch and show depths.

GROUND LEVEL

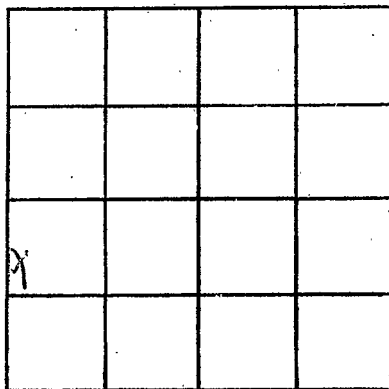

SECTION 15

Please indicate well location X.

ADDITIONAL INFORMATION

If more than one screen, show locations of each on sketch.