

WALTHALL

D 2024

8-30-78

MISSISSIPPI BOARD OF WATER COMMISSIONERS
416 North State Street
Jackson, Mississippi 39201

WATER WELL DRILLERS LOG

Aug 30 1978
date well completed

Pennsylvania
firm name

Walthall
county well located

LANDOWNER:

Ken Fortenberry
(Braceydale) Rt 2 Tylitown
(mailing address)

description of formations encountered

from to

red sandy clay	0	22
red sand	22	56
big gravel	56	70
red gravel sand	70	84

WELL LOCATION:

sec. 3 T 3 N R 11 E
3 1/2 miles E-NE of Salem
(distance) (direction) (nearest town)

WELL PURPOSE: home
(home, irrigation, municipal, industrial)

WELL COMPLETION DATA:

- (1) diameter (inches) 4"
- (2) total depth (feet) 84
- (3) static water level (feet) 42 below top of ground
- (4) casing plastic, cotton (material) (depth)
- (5) screen 5' 79' (length) (depth to top)
4" plastic (size) (material)
- (6) pump 1/2 HP 10 (HP) (yield gpm)
elect (type power)
- (7) electric log no (yes or no)
- (organization running log)

(8) how well bottom plugged
wood plug

DRILLERS REMARKS:


L

RECEIVED
JAN 15 1978

MISS. RD. OF WATER COMMISSIONERS

If well telescopes please sketch and show depths.

GROUND LEVEL

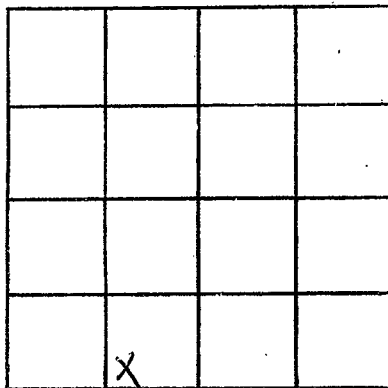

SECTION 3

Please indicate well location X.

ADDITIONAL INFORMATION

If more than one screen, show locations of each on sketch.