

WALTHALL
 2055 D
 7-14-78

MISSISSIPPI
 BOARD OF WATER COMMISSIONERS
 416 North State Street
 Jackson, Mississippi 39201

WATER WELL DRILLERS LOG

7-14 1978 Fitzsimmons Well Serv Walthall
 date well completed firm name county well located

LANDOWNER:
O.C. Batchiff
R.R. Tolson
 (mailing address)

description of formations encountered	from	to
	<u>Red clay</u>	<u>0</u>
<u>Red sand</u>	<u>20</u>	<u>10</u>
<u>Coarse sand gravel</u>	<u>70</u>	<u>80</u>

WELL LOCATION:
 sec 34 T 3 N R 11 E
7 miles SE of Tolson
 (distance) (direction) (nearest town)

WELL PURPOSE: Home
 (home, irrigation, municipal, industrial)

- WELL COMPLETION DATA:
- (1) diameter (inches) 4
 - (2) total depth (feet) 80
 - (3) static water level (feet) 70 below above top of ground.
 - (4) casing PVC 72
 (material) (depth)
4 If telescope see back.
 (size)
 - (5) screen 8 72
 (length) (depth to top)
4 PVC
 (size) (material)
 - (6) pump 1/2 10
 (HP) (yield gpm)
Electric
 (type power)
 - (7) electric log no
 (yes or no)
 - (8) how well bottom plugged Sand block
 (organization running log)


DRILLERS REMARKS:

RECEIVED
 AUG 14 1978

MISS. BD. OF WATER COMMISSIONERS

If well telescopes please sketch and show depths.

GROUND LEVEL

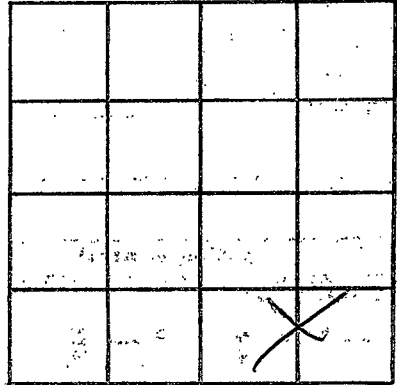

SECTION 34

Please indicate well location X.

ADDITIONAL INFORMATION

If more than one screen,
show locations of each on sketch.