

WALTHALL  
 D *2020*  
 12-06-78

MISSISSIPPI  
 BOARD OF WATER COMMISSIONERS  
 416 North State Street  
 Jackson, Mississippi 39201

WATER WELL DRILLERS LOG

*12-6* 19 *78* *Fitzgerald well* *Walthall*  
 date well completed firm name county well located

LANDOWNER:  
*Reggie McRenzie*  
*B.R. Lybourn, ms.*  
 (mailing address)

description of formations encountered	from	to
<i>Red clay</i>	<i>0</i>	<i>20</i>
<i>Red sand &amp; gravel</i>	<i>20</i>	<i>100</i>
<i>Coarse sand &amp; gravel</i>	<i>100</i>	<i>115</i>

WELL LOCATION:  
 sec. *20* T *3* N R *11* E  
                   S                  W  
*4* miles *N* of *Lybourn*  
 (distance) (direction) (nearest town)

WELL PURPOSE: *Home*  
 (home, irrigation, municipal, industrial)

WELL COMPLETION DATA:

(1) diameter (inches) *4*

(2) total depth (feet) *115*

(3) static water level (feet) *70* below top of ground.

(4) casing *PVC 107*  
 (material) (depth)  
*4* If telescope see back.  
 (size)

(5) screen *8* *107*  
 (length) (depth to top)  
*4* *PVC*  
 (size) (material)

(6) pump *1/2* *10*  
 (HP) (yield gpm)  
*elm*  
 (type power)

(7) electric log *no*  
 (yes or no)  
 (organization running log)

(8) how well bottom plugged *sand filter*


DRILLERS REMARKS:

RECEIVED  
 JAN 26 1978

MISS. BD. OF WATER COMM.

If well telescopes please sketch and show depths.

GROUND LEVEL

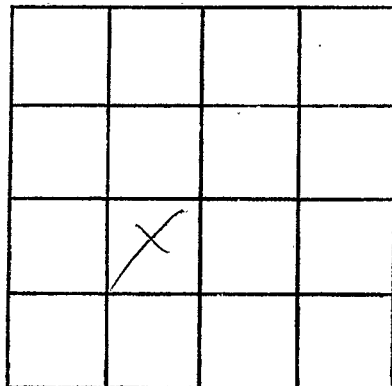

SECTION 20

Please indicate well location X.

ADDITIONAL INFORMATION

If more than one screen, show locations of each on sketch.