

WALTHALL
D 2057
3-29-79

MISSISSIPPI
BOARD OF WATER COMMISSIONERS
416 North State Street
Jackson, Mississippi 39201

WATER WELL DRILLERS LOG

3-29 19 79 Fitzgerald Well Serv Walthall
date well completed firm name county well located

LANDOWNER:
Claude Fortenbery
R.R. Lytleman
(mailing address)

description of formations encountered	from to	
	feet	feet
Red clay	0	20
Red sand	20	80
Red gravel	80	105
Coarse sand & gravel	105	115

WELL LOCATION:
sec. 31 T. 30 N. R. 11 E
6 miles NNE of Lytleman
(distance) (direction) (nearest town)

WELL PURPOSE: Home
(home, irrigation, municipal, industrial)

- WELL COMPLETION DATA:
- (1) diameter (inches) 4
 - (2) total depth (feet) 115
 - (3) static water level (feet) 75 below top of ground.
 - (4) casing PVC 107,
(material) (depth)
4 if telescope see back.
(size)
 - (5) screen 8, 107
(length) (depth to top)
4, PVC
(size) (material)
 - (6) pump 1/2, 10
(HP) (yield gpm)
oh
(type power)
 - (7) electric log no
(yes or no)
(organization running log)
 - (8) how well bottom plugged Sand hole

DRILLERS REMARKS:


Miss. Board of Water Comm.

MAY 30 1979

RECEIVED

If well telescopes please sketch and show depths.

GROUND LEVEL

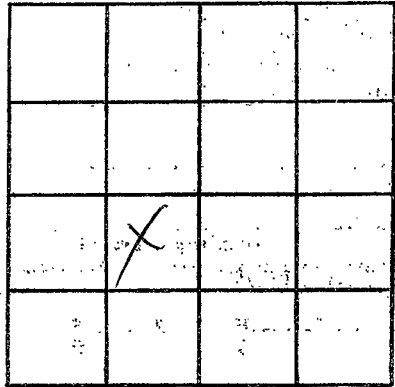

SECTION 31

Please indicate well location X.

ADDITIONAL INFORMATION

If more than one screen, show locations of each on sketch.