

WALTHALL

D 2032

1-03-79

MISSISSIPPI BOARD OF WATER COMMISSIONERS
416 North State Street
Jackson, Mississippi 39201

WATER WELL DRILLERS LOG

1-3 date well completed

19 29

Fitzgerald Inc firm name

Walthall county well located

LANDOWNER:

James Sinn

P.R. Lybourn

(mailing address)

description of formations encountered

from

to

Red clay

0

20

Red sand

20

80

Coarse sand & gravel

80

89

WELL LOCATION:

sec. 7 T 3 N S

R 11 E W

6 miles 4 of Lybourn
(distance) (direction) (nearest town)


WELL PURPOSE:

Home
(home, irrigation, municipal, industrial)

WELL COMPLETION DATA:

- (1) diameter (inches) 4
- (2) total depth (feet) 89
- (3) static water level (feet) 65 below top of ground.
- (4) casing PVC 81, (material) (depth)
4 (size) If telescope see back.
- (5) screen 8, 81 (length) (depth to top)
4, PVC (size) (material)
- (6) pump 1/2, 10 (HP) (yield gpm)
Elec (type power)
- (7) electric log No (yes or no)
- (organization running log)
- (8) how well bottom plugged Sand plug

DRILLERS REMARKS:

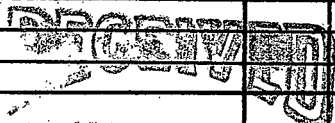


JAN 26 1979

MISS. BD. OF WATER COMMISSIONERS

If well telescopes please
sketch and show depths.

GROUND LEVEL

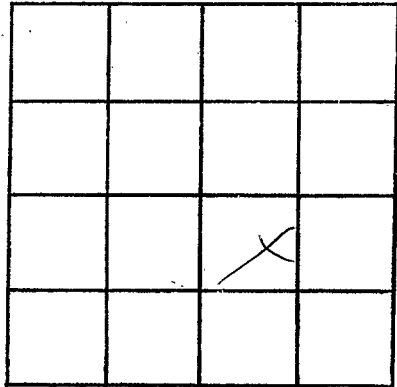

SECTION 2

Please indicate well location X.

ADDITIONAL INFORMATION

If more than one screen,
show locations of each on sketch.