

MISSISSIPPI DEPARTMENT OF NATURAL RESOURCES

Bureau of Land and Water Resources

Southport Mall

P.O. Box 10631

Jackson, Mississippi 39209

WATER WELL DRILLERS LOG

WALTHALL  
D 2035  
10-4-79

Oct-4 19 79 Rever Miller Walthall  
 date well completed firm name county well located

LANDOWNER:  
Frank Kennedy  
Rt 3 Tylletown  
 (mailing address)

description of formations encountered	from	to
<u>Play</u>	<u>9</u>	<u>17</u>
<u>Red sand</u>	<u>17</u>	<u>102</u>
<u>Chalky sand</u>	<u>102</u>	<u>115</u>
<u>blue clay</u>	<u>115</u>	<u>164</u>
<u>Coarse sand</u>	<u>164</u>	<u>180</u>

WELL LOCATION:  
 sec. 29 T. 3 N R. 11 E  
5 1/2 miles north of Tylletown  
 (distance) (direction) (nearest town)

WELL PURPOSE: home  
 (home, irrigation, municipal, industrial)

WELL COMPLETION DATA:

(1) diameter (inches) 4"

(2) total depth (feet) 180

(3) static water level (feet) 76 below above top of ground.

(4) casing plastic bottom  
 (material) (depth)

         if telescope see back.  
 (size)

(5) screen 5' 175  
 (length) (depth to top)

4" plastic  
 (size) (material)

(6) pump 1/2 hp             
 (HP) (yield gpm)

electric  
 (type power)

(7) electric log no  
 (yes or no)

          
 (organization running log)

(8) how well bottom plugged  
wooden plug

DRILLERS REMARKS:  
old well pumped  
sand & mud -


DEPT. OF NATURAL RESOURCES  
 BUREAU OF LAND & WATER RESOURCES

OCT - 9 1980

RECEIVED

If well telescopes please sketch and show depths.

GROUND LEVEL

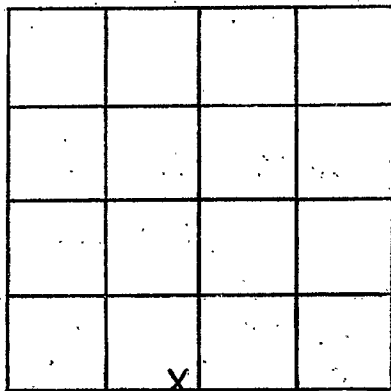

SECTION 29

Please indicate well location X.

ADDITIONAL INFORMATION

If more than one screen,  
show locations of each on sketch.