

Walthell
D 2536
6-13-80

MISSISSIPPI
 BOARD OF WATER COMMISSIONERS
 416 North State Street
 Jackson, Mississippi 39201

WATER WELL DRILLERS LOG


6-13 1980 Hygeine well for Walthell
 date well completed firm name county well located

LANDOWNER:	description of formations encountered	from	to
<u>Frank Whittington</u>			
<u>RR. Lybster</u> (mailing address)	<u>Red Clay</u> <u>Grice Sand & white shell</u> <u>Coarse Sand & gravel</u>	<u>0</u> <u>20</u> <u>95</u>	<u>20</u> <u>95</u> <u>105</u>
WELL LOCATION:			
sec. <u>32</u> T. <u>3</u> N. R. <u>11</u> E.			
<u>6</u> miles <u>N</u> of <u>Lybster</u> (distance) (direction) (nearest town)			
WELL PURPOSE: <u>Home</u> (home, irrigation, municipal, industrial)			
WELL COMPLETION DATA:			
(1) diameter (inches) <u>4</u>			
(2) total depth (feet) <u>105</u>			
(3) static water level (feet) <u>10</u> below above top of ground.			
(4) casing <u>PVC</u> , <u>97</u> (material) (depth)			
<u>4</u> if telescope see back. (size)			
(5) screen <u>8</u> , <u>97</u> (length) (depth to top)			
<u>4</u> , <u>PVC</u> (size) (material)			
(6) pump <u>1/2</u> <u>10</u> (HP) (yield gpm)			
<u>elc</u> (type power)			
(7) electric log <u>no</u> (yes or no)			
(organization running log)			
(8) how well bottom plugged <u>Sand fill</u>			
DRILLERS REMARKS:			

Keep
open
well

If well telescopes please sketch and show depths.

GROUND LEVEL

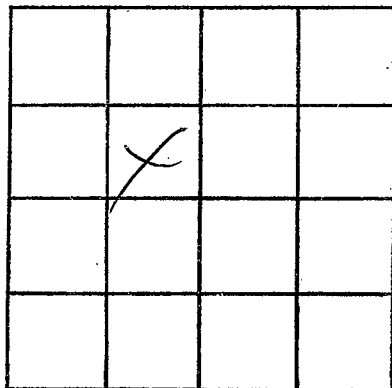

SECTION 32

Please indicate well location X.

ADDITIONAL INFORMATION

If more than one screen,
show locations of each on sketch.