

WALTHALL
D 2037
10-6-80

MISSISSIPPI
BOARD OF WATER COMMISSIONERS
416 North State Street
Jackson, Mississippi 39201

WATER WELL DRILLERS LOG

10-6 1980 *Fitzgerald Well Serv* *Walthall*
date well completed firm name county well located

LANDOWNER:	description of formations encountered	from	to
<i>Ralph Walters</i>			
<i>R.R. Tylertown</i> (mailing address)	<i>Red Clay</i>	<i>0</i>	<i>20</i>
WELL LOCATION:	<i>Red sand</i>	<i>20</i>	<i>95</i>
sec. <i>18</i> T. <i>3</i> N. R. <i>X E</i> S <i>5</i> miles <i>N</i> of <i>Tylertown</i> (distance) (direction) (nearest town)	<i>Coarse sandstone</i>	<i>95</i>	<i>116</i>
WELL PURPOSE: <i>Home</i> (home, irrigation, municipal, industrial)			
WELL COMPLETION DATA:			
(1) diameter (inches) <i>4</i>			
(2) total depth (feet) <i>116</i>			
(3) static water level (feet) <i>55</i> below above top of ground.			
(4) casing <i>PVC</i> , <i>108</i> , (material) (depth) <i>4</i> (size) if telescope see back.			
(5) screen <i>8</i> , <i>108</i> (length) (depth to top)			
<i>4</i> , <i>PVC</i> (size) (material)			
(6) pump <i>1/2</i> , <i>10</i> (HP) (yield gpm) <i>Elco</i> (type power)			
(7) electric log <i>No</i> (yes or no)			
(organization running log)			
(8) how well bottom plugged <i>Sand</i>			
DRILLERS REMARKS:			


DEPT. OF NATURAL RESOURCES
BUREAU OF LAND & WATER RESOURCES

DEC - 9 1980

RECEIVED

If well telescopes please sketch and show depths.

GROUND LEVEL

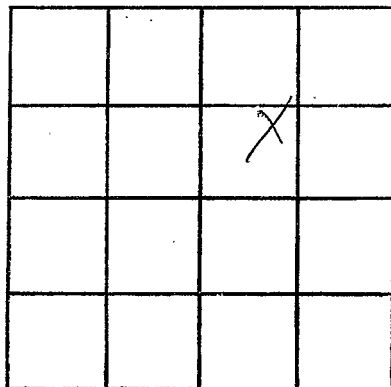

SECTION 18

Please indicate well location X.

ADDITIONAL INFORMATION

If more than one screen, show locations of each on sketch.