

WALTHALL

D 2038

12-4-80

MISSISSIPPI BOARD OF WATER COMMISSIONERS 416 North State Street Jackson, Mississippi 39201

WATER WELL DRILLERS LOG

12-4 date well completed

1980 Fitzgerald Well Co firm name

Walthall county well located

LANDOWNER:

Billy Boyd

RR. Giltown (mailing address)

description of formations encountered

from to

Red Clay

6 20

Red Sand

20 80

Blue Clay

80 120

Crane Sand & Gravel

125 135

WELL LOCATION:

sec. 13 T. 3 N R. 11 E

9 miles ENE of Giltown (distance) (direction) (nearest town)

WELL PURPOSE:

(home, irrigation, municipal, industrial)

WELL COMPLETION DATA:

(1) diameter (inches) 4

(2) total depth (feet) 135

(3) static water level (feet) 90 below top of ground

(4) casing PVC, 127 (material), (depth)

4 (size) if telescope see back.

(5) screen 8, 127 (length), (depth to top)

4 (size), PVC (material)

(6) pump 1/2 (HP), 10 (yield gpm)

el (type power)

(7) electric log no (yes or no)

(organization running log)

(8) how well bottom plugged Substr

DEPT. OF NATURAL RESOURCES BUREAU OF LAND & WATER RESOURCES


DRILLERS REMARKS:

DEC - 9 1980

RECEIVED

If well telescopes please sketch and show depths.

GROUND LEVEL

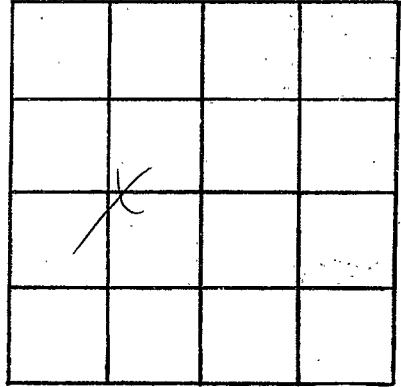

SECTION 13

Please indicate well location X.

ADDITIONAL INFORMATION

If more than one screen,
show locations of each on sketch.