




If well telescopes please sketch and show depths.

GROUND LEVEL

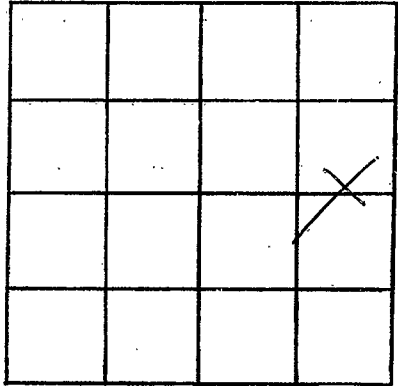

SECTION ~~2~~ 4

Please indicate well location X.

ADDITIONAL INFORMATION

Lined area for additional information.

If more than one screen, show locations of each on sketch.