

WALTHALL  
 D 2004  
 3-10-80

MISSISSIPPI  
 BOARD OF WATER COMMISSIONERS  
 416 North State Street  
 Jackson, Mississippi 39201

WATER WELL DRILLERS LOG

3-10-80 date well completed 1980 firm name Fitzgibbon Well Drilling Walthall county well located

LANDOWNER:	description of formations encountered	from	to
Steve McKenzie R.R. 1, Tylertown (mailing address)			
WELL LOCATION:			
sec. 16 T. 3 N R. 11 E S W			
2 miles SE of Salem (distance) (direction) (nearest town)			
WELL PURPOSE: (home, irrigation, municipal, industrial)			
Home			
WELL COMPLETION DATA:			
(1) diameter (inches) 4			
(2) total depth (feet) 148			
(3) static water level (feet) 53 below top of ground.			
(4) casing PVC 140 (material) (depth) 4 (size) if telescope see back.			
(5) screen 8 140 (length) (depth to top) 4 PVC (size) (material)			
(6) pump 1/2 10 (HP) (yield gpm) alt (type power)			
(7) electric log no (yes or no) (organization running log)			
(8) how well bottom plugged Sand fill			

DRILLERS REMARKS:


DEPT. OF NATURAL RESOURCES  
 BUREAU OF LAND & WATER RESOURCES

MAR 25 1980

RECEIVED

If well telescopes please sketch and show depths.

GROUND LEVEL

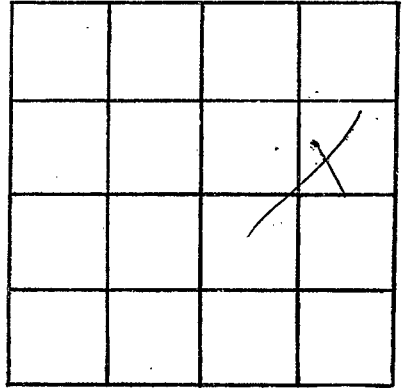

SECTION 16

Please indicate well location X.

ADDITIONAL INFORMATION

If more than one screen, show locations of each on sketch.