

MISSISSIPPI DEPARTMENT OF NATURAL RESOURCES

Bureau of Land and Water Resources

Southport Mall

P.O. Box 10631


Jackson, Mississippi 39209

WATER WELL DRILLERS LOG

WALTHALL
D 2042
3-27-81

March 27, 1981 Reems Miller Walthall
date well completed firm name county well located

LANDOWNER:	description of formations encountered	from	to
James Piggott Rt Tylertown (mailing address)			
WELL LOCATION: sec. 33 T. 11 N. R. 12 E ? 5 miles north of Tylertown (distance) (direction) (nearest town)			
WELL PURPOSE: <u>Comp</u> (home, irrigation, municipal, industrial)			
WELL COMPLETION DATA:			
(1) diameter (inches) <u>4"</u>			
(2) total depth (feet) <u>83</u>			
(3) static water level (feet) <u>12'</u> below above top of ground.			
(4) casing <u>plastic bottom</u> (material) (depth)			
<u>4"</u> If telescope see back. (size)			
(5) screen <u>5' 78'</u> (length) (depth to top)			
<u>4"</u> <u>plastic</u> (size) (material)			
(6) pump <u>1/2 HP</u> <u>10</u> (HP) (yield gpm)			
<u>elect</u> (type power)			
(7) electric log <u>no</u> (yes or no)			
<u>←</u> (organization running log)			
(8) how well bottom plugged <u>backwash</u>			
DRILLERS REMARKS:			

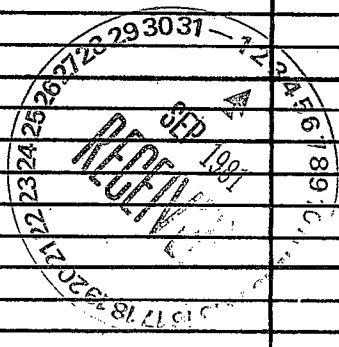

If well telescopes please sketch and show depths.

GROUND LEVEL

		X	

SECTION 33

Please indicate well location X.

ADDITIONAL INFORMATION

If more than one screen,
show locations of each on sketch.