


Walthall
 DAWK
 7-1-81

MISSISSIPPI
 BOARD OF WATER COMMISSIONERS
 416 North State Street
 Jackson, Mississippi 39201

WATER WELL DRILLERS LOG


7-1 1981 86 Fitzgerald well Walthall
 date well completed firm name county well located

LANDOWNER:	description of formations encountered	from	to
<u>James E. Rushing</u>	<u>Red clay</u>	<u>0</u>	<u>20</u>
<u>R.B. Lytle</u> (mailing address)	<u>Red sand</u>	<u>20</u>	<u>90</u>
	<u>Coarse sand & gravel</u>	<u>90</u>	<u>103</u>
WELL LOCATION:			
sec. <u>10</u> T. <u>3</u> N R. <u>11</u> E S W			
<u>3</u> miles <u>E</u> of <u>Selma</u> (distance) (direction) (nearest town)			
WELL PURPOSE:			
(home, irrigation, municipal, industrial)			
WELL COMPLETION DATA:			
(1) diameter (inches) <u>4</u>			
(2) total depth (feet) <u>103</u>			
(3) static water level (feet) <u>65</u> below above top of ground.			
(4) casing <u>PVC 95</u> (material) (depth)			
<u>4</u> if telescope see back. (size)			
(5) screen <u>8 95</u> (length) (depth to top)			
<u>4</u> <u>PVC</u> (size) (material)			
(6) pump <u>1/2 10</u> (HP) (yield gpm)			
<u>Electric</u> (type power)			
(7) electric log <u>no</u> (yes or no)			
(organization running log)			
(8) how well bottom plugged <u>Small</u>			
DRILLERS REMARKS:			

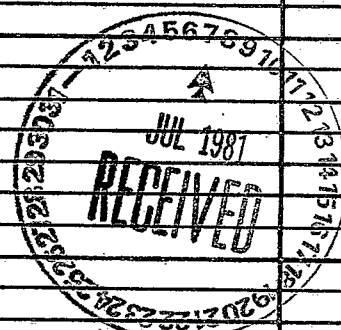

If well telescopes please sketch and show depths.

GROUND LEVEL

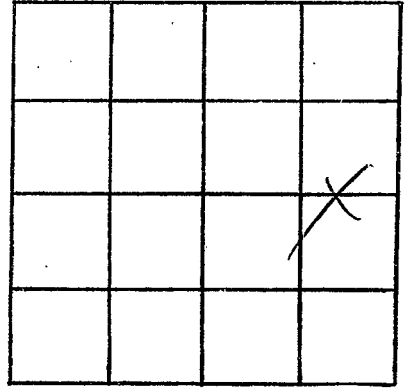

SECTION 10

Please indicate well location X.

ADDITIONAL INFORMATION

If more than one screen,
show locations of each on sketch.