

Walthall
 D 2045
 4-30-81

MISSISSIPPI DEPARTMENT OF NATURAL RESOURCES
 Bureau of Land and Water Resources
 Southport Mall
 P.O. Box 10631
 Jackson, Mississippi 39209
 WATER WELL DRILLERS LOG

April 13 1981 Runs Miller Walthall
 date well completed firm name county well located

LANDOWNER:
 Nean Ratchiff
 Rt 1 Poplarville
 (mailing address)


description of formations encountered	from	to
clay	0	14
sand & gravel	14	25
pink shale	25	50
shale & clay	50	80
sand & gravel	80	90

WELL LOCATION:
 sec. 11 T-3 N R-11 E
 1/2 miles south of Salem
 (distance) (direction) (nearest town)

WELL PURPOSE: Trade
 (home, irrigation, municipal, industrial)


- WELL COMPLETION DATA:
- (1) diameter (inches) 4"
 - (2) total depth (feet) 90'
 - (3) static water level (feet) 53' below top of ground.
 - (4) casing plastic bottom
 (material) (depth)
 (size) if telescope see back.
 - (5) screen 5' 85'
 (length) (depth to top)
 4" plastic
 (size) (material)
 - (6) pump 1/2 sub 10
 (HP) (yield gpm)
 sheet
 (type power)
 - (7) electric log no
 (yes or no)
 (organization running log)
 - (8) how well bottom plugged
 closed

DRILLERS REMARKS:

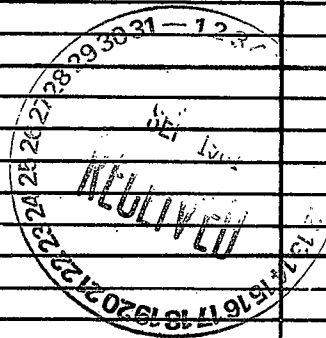

If well telescopes please sketch and show depths.

GROUND LEVEL

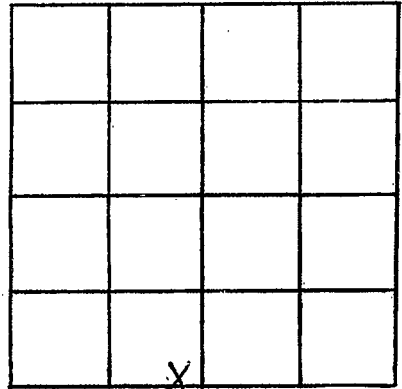

SECTION 17

Please indicate well location X.

ADDITIONAL INFORMATION

If more than one screen,
show locations of each on sketch.