

MISSISSIPPI DEPARTMENT OF NATURAL RESOURCES

Bureau of Land and Water Resources

Southport Mall

P.O. Box 10631

Jackson, Mississippi 39209

WATER WELL DRILLERS LOG

Walthall
D 2047
4-24-81

April 24 1981 Reens Walker Walthall
date well completed firm name county well located

LANDOWNER:
Clementine Quinn
Rt Tylertown
(mailing address)

description of formations encountered	from	to
<u>clay</u>	<u>0</u>	<u>16</u>
<u>Red sand</u>	<u>16</u>	<u>54</u>
<u>fine Chalk</u>	<u>54</u>	<u>80</u>
<u>Coarse sand</u>	<u>80</u>	<u>93</u>

WELL LOCATION:
sec. 29 T 3 N R 11 E
3 miles South of Salem
(distance) (direction) (nearest town)

WELL PURPOSE: water
(home, irrigation, municipal, industrial)

- WELL COMPLETION DATA:
- (1) diameter (inches) 4"
 - (2) total depth (feet) 93'
 - (3) static water level (feet) 65' below top of ground.
 - (4) casing Plastic, Watton
(material) (depth)
 - (5) screen 5' 88'
(length) (depth to top)
 - (6) pump 4" plastic
(size) (material)
 - (7) pump 2HP 10
(type power) (yield gpm)
 - (8) electric log no
(yes or no)
 - (9) no
(organization running log)
 - (10) how well bottom plugged Backwash Valve

DRILLERS REMARKS:
Backwash Valve


DEPT. OF NATURAL RESOURCES
BUREAU OF LAND & WATER RESOURCES

OCT-1 1981

RECEIVED

If well telescopes please sketch and show depths.

GROUND LEVEL

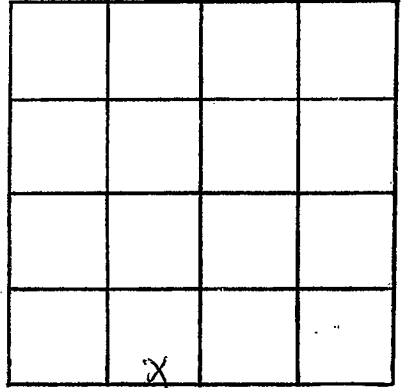

SECTION 29

Please indicate well location X.

ADDITIONAL INFORMATION

If more than one screen,
show locations of each on sketch.